


Section 10 Township 30 Range 4E

Well No. #1 Akers

Company Stelbar Oil et al

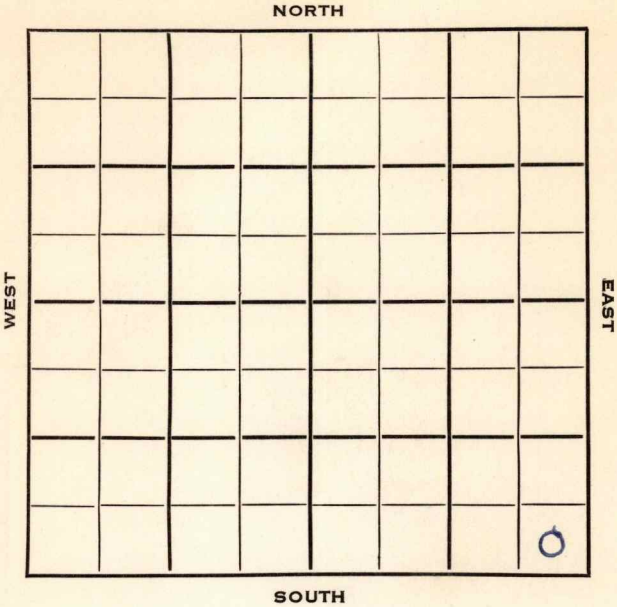

Cowley KANSAS ✓

Sec. 10 Twp. 30 R. 4E

Well No. #1 Akers Farm

Stelbar Oilet al Company

Stelbar Contractor

Rock Pool


 Ft. from N. Line

330 Ft. from S. Line

330 Ft. from E. Line

 Ft. from W. Line

SE SE SE

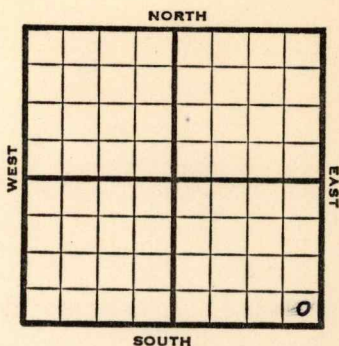

1953

Elev. 1184' REPORT

5/6

MIM

6/10

Spud 5-5-53 D & A TD 2788
8" @ 63 Bart. 2768 TD 2788
~~5~~ 5" @ 2768 CO to 2788
1 qt. OPH PB 2781
D & A

ABANDONED

County **Cowley** State **Kansas**Sec. **10** (Blk.) **30** (Sur.) **4E** Map No.
(Twp.) (Rge.)Operator **Stelbar Oil etal.**Well No. **1** Farm **Akers**Elev. Location **SE SE SE**

FIRST REPORT

330 Ft. From **S** Line **SE****330** Ft. From **E** Line Quarter1st. Report **MAY 6 1953**

Completion

Remarks

Stelbar - Contr.

Spudding Date

Drlg. Data **Rock Pool****M I M**

County Cowley State Kansas
 Sec. 10 (Blk. 30 (Sur. 4E Map No.
 (Twp. (Rge.
 Operator Stelbar Oil etal.
 Well No. 1 Farm Akers
 Elev. 1184 Location SE SE SE



330Ft. From S Line SE
330Ft. From E Line Quarter
 1st. Report
 Completion JUN 1 0 1953
 Remarks Rock Pool
Stelbar- Contr.
 Spudding Date 5-5-53

Drlg. Data D & A TD 2788
8" @ 63 Bart. 2768 TD 2788
5" @ 2768 CO to 2788 1 qt oph PB 2781
D & A