


Section 2 Township 15 Range 14W

Well No. 4 Flegler "B"

Company Co-op

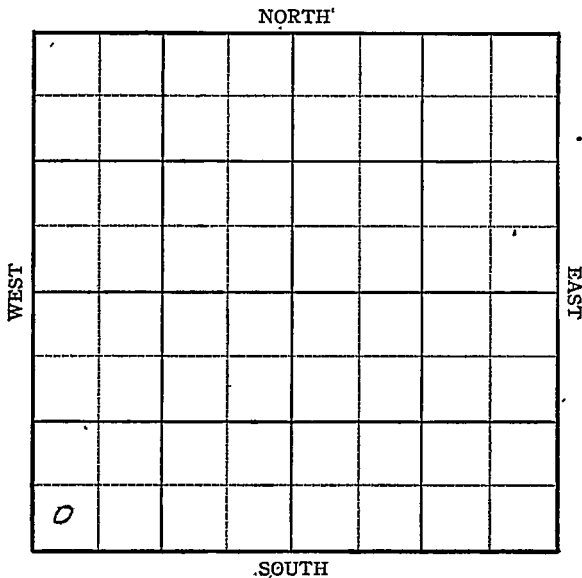

Sec. 2 Twp. 15 R. 14-W

Well No. #4 Flegler "B" Farm _____


Co-op Company _____

_____ Ft. from N. Line

330 Ft. from S. Line

_____ Ft. from E. Line

330 Ft. from W. Line

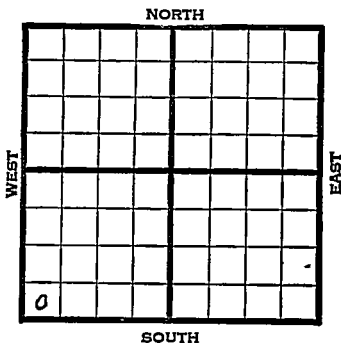

SW/4 Elev. 1721

1945

REPORT

8/22 Rig
8/29 15 1/2" @ 86
Drlg. 335
9/5 12" @ 380
10" @ 742 WOC
9/12 Anhy 735
Drlg. 1810'
9/19 8 1/2" @ 2260
Tarkio 2309'
SO 2309-2316
Tested 2 oil plus 9 gals. Wtr. in 30 min.
2365 UR 8"
9/28 8" @ 2425'
Topeka 2631
Drlg. 2755
10/3 Lans 2932
6" @ 3022
30' oil 1 hr.
Cong 3180
Arb. 3205-3222
TD 3222 No shows.
PB 3070
5" @ 3070 PBP
10/10 PB 3042
44 shots 3015-3027 CO
10/17 3500 acid.
Swb. 1/4 oil SWPH 12 hrs. Squeeze
10/24 Lane Wells Plug 2405
6 shots 2400 squ. 250 sks.
10/31 44 shots 2303-2316 2500 acid.
Pump 40 oil 24 hrs.

OVER

1945

11/7 Waiting on pumping unit

11/14 " " "

11/21 " " "

11/28 Lans 2932

Arb. 3205

5" @ 3070

Perf. Lans 6000 acid.

TD 3222

Pump 76 Pot.

Grav. 40.0

COMPLETED

KANSAS Pool Name TrappMap No. 73 Sec. 2 Twp. 15 R. 14WWell No. 4 Flegler "B"

Co-op _____ Company _____

FIRST REPORT _____ Contractor _____

SW/c

SECTION PLAT

_____ Ft. from N. Line

330 Ft. from S. Line

_____ Ft. from E. Line

330 Ft. from W. Line

Russell County

Location _____

Rig up _____

Drilling and Remarks:

rig

RECORD

Cased _____ in., _____ ft.

Sand _____

Gas _____

Oil _____

Total Depth _____

PRODUCTION

1st 24 hrs. Nat. _____

1st 24 hrs. after shot _____

Gas _____ Cu. Ft.

Dry Hole _____

Abandoned _____

Date

AUG 22 1945 19S. J. LEWIS

Scout

KANSAS

Kansas Pool Name TrappMap No. 73 Sec. 2 Twp. 15 R. 14WWell No. 4 Flegler "B"

Co-op _____ Company _____

COMPLETED Contractor _____


SW/c

E. 1721
SECTION PLAT

_____ Ft. from N. Line

330 Ft. from S. Line

_____ Ft. from E. Line

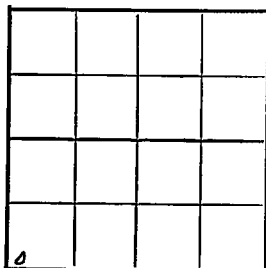330 Ft. from W. Line

Russell County

Location _____

Rig up _____

Drilling and Remarks:

Log 2932Cost 32055" @ 3070Perf. 10006000 acialPerf 76 Rod40° Gr

Date

RECORD

Cased _____ in., _____ ft.

Sand _____

Gas _____

Oil _____

Total Depth 3222

PRODUCTION

1st 24 hrs. Nat. _____

1st 24 hrs. after shot _____

Gas _____ Cu. Ft.

Dry Hole _____

Abandoned _____

NOV 28 1945

19

S. J. LEWIS

Scout