


Map No. _____ Sec. 10 Twp. 30 R. 4

Well No. 1 Goshen Farm

White Eagle

Company

NORTH

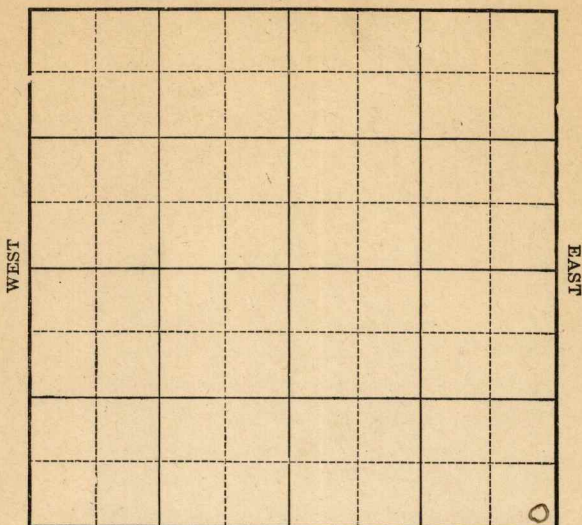

Location _____

Drilling Remarks:

Rig Up_____

Drilling Remarks:

RECORD

Cased _____ in. _____ ft.

Sand _____

Gas _____

Oil_____

Total Depth _____

PRODUCTION

1st 24 hrs. Nat. _____

1st 24 hrs. after shot_____

Gas _____ cu. ft.

Dry Hole _____

Abandoned _____

Map No. **KANSAS** Sec. *10* Twp. *30* R. *4*

Well No. *1 Gasline*
White Eagle Company

Contractor

COMPLETED

SECTION PLAT

----- Ft. from N. Line

100 ----- Ft. from S. Line

100 ----- Ft. from E. Line

----- Ft. from W. Line

Location -----

Rig up -----

Drilling and Remarks:

sand 12768
2784
35/40

RECORD

Cased ----- in., ----- ft.

Sand -----

Gas -----

Oil -----

Total Depth -----

PRODUCTION

1st 24 hrs. Nat. -----

1st 24 hrs. after shot -----

Gas ----- Cu. Ft.

Dry Hole -----

Abandoned -----

Date

JUN 23 1923

M. A. BENEAR

192

Scout

Map No. KANSAS Sec. 10 Twp. 30 R. 4Well No. 1 JaslinWhite & Agell Company

Contractor

FIRST REPORT

Ft. from N. Line

100 Ft. from S. Line100 Ft. from E. Line

Ft. from W. Line

SECTION PLAT

			0

Location

Rig up ✓✓

Drilling and Remarks:

RECORD

Cased _____ in., _____ ft.

Sand _____

Gas _____

Oil _____

Total Depth _____

PRODUCTION

1st 24 hrs. Nat. _____

1st 24 hrs. after shot _____

Gas _____ Cu. Ft.

Dry Hole _____

Abandoned _____

Date JAN 26 1923

191 M. A. BENTLEY Scout