


Map No. \_\_\_\_\_ Sec. 11 Twp. 30 R. 4

Well No. 1 Joslin Farm \_\_\_\_\_  
Byssy Company \_\_\_\_\_

NORTH (Isiah Joslin)

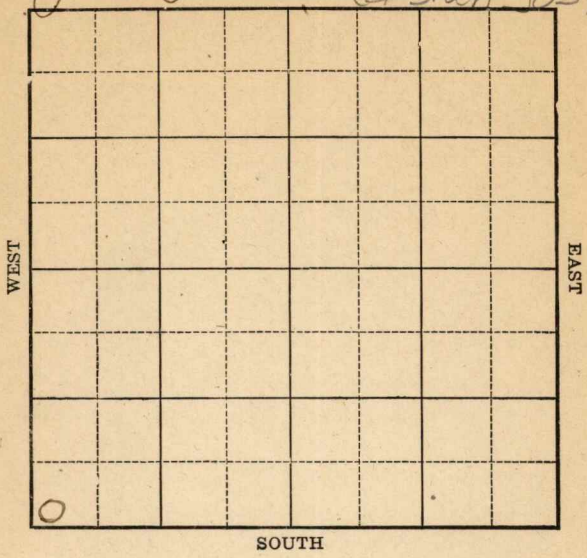

Location \_\_\_\_\_

Drilling Remarks:

\_\_\_\_\_

\_\_\_\_\_

Rig Up \_\_\_\_\_

Drilling Remarks:

\_\_\_\_\_

\_\_\_\_\_

\_\_\_\_\_

\_\_\_\_\_

\_\_\_\_\_

\_\_\_\_\_

\_\_\_\_\_

\_\_\_\_\_

\_\_\_\_\_

\_\_\_\_\_

**RECORD**

Cased \_\_\_\_\_ in. \_\_\_\_\_ ft.

Sand \_\_\_\_\_

Gas \_\_\_\_\_

Oil \_\_\_\_\_

Total Depth \_\_\_\_\_

**PRODUCTION**

1st 24 hrs. Nat. \_\_\_\_\_

1st 24 hrs. after shot \_\_\_\_\_

Gas \_\_\_\_\_ cu. ft.

Dry Hole \_\_\_\_\_

Abandoned \_\_\_\_\_



Map No. **KANSAS** Sec. 11 Twp. 30 R. 4

Well No. 1 Gasline

Gypsum Company  
Contractor

**COMPLETED**

**SECTION PLAT**

----- Ft. from N. Line  
200 Ft. from S. Line  
----- Ft. from E. Line  
200 Ft. from W. Line


**RECORD**

Location -----

Rig up -----

Drilling and Remarks:

sand / 2779  
2788  
7.D. 279.0  
30 / 250 fms.

Cased ----- in., ----- ft.  
Sand -----  
Gas -----  
Oil -----  
Total Depth -----

**PRODUCTION**

1st 24 hrs. Nat. -----  
1st 24 hrs. after shot -----  
Gas ----- Cu. Ft.  
Dry Hole -----  
Abandoned -----

Date

**JUN 23 1923**

**M. A. BENEAR**

Map No. **KANSAS** Sec. *11* Twp. *30* R. *4*

Well No. *1 Gaslin*

Company \_\_\_\_\_ Contractor \_\_\_\_\_

FIRST REPORT

SECTION PLAT

\_\_\_\_\_ Ft. from N. Line

*200* Ft. from S. Line

\_\_\_\_\_ Ft. from E. Line

*200* Ft. from W. Line

<i>0</i>			

Location \_\_\_\_\_  
Rig up \_\_\_\_\_  
Drilling and Remarks:

RECORD

Cased \_\_\_\_\_ in., \_\_\_\_\_ ft.  
Sand \_\_\_\_\_  
Gas \_\_\_\_\_  
Oil \_\_\_\_\_  
Total Depth \_\_\_\_\_

PRODUCTION

1st 24 hrs. Nat. \_\_\_\_\_  
1st 24 hrs. after shot \_\_\_\_\_  
Gas \_\_\_\_\_ Cu. Ft.  
Dry Hole \_\_\_\_\_  
Abandoned \_\_\_\_\_

Date **JAN 26 1923**

191

**M. A. RENEAR** Scout