

KANSAS

Form 51-5M-7-40-Palace


Barton

Section 5 Township 16 Range 13-W

Well No. #14 Bitter "B"

Company Shell

NORTH Trapp Pool

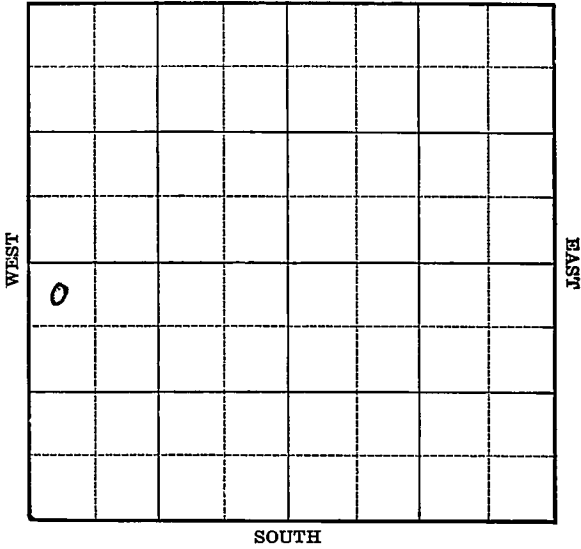

Sec. 5 Twp. 16 R. 13-W

Well No. #14 Bitter "B" Farm _____

Shell Company
(Trapp)


330 Ft. from N. Line

_____ Ft. from S. Line

_____ Ft. from E. Line

435 Ft. from W. Line

Elev. 1883

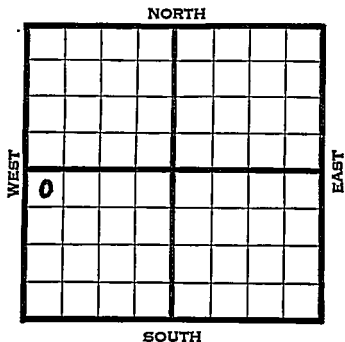

1941	REPORT
3/5	Drlg. 260'
3/13	8" - 629' Drlg. 2493'
3/20	Topeka 277 4' Lans. 3081'
	Arb. 3317-19' T.D. 4" - 3318'
	RUST.
3/27	T.D. 3327' 6000 acid.
	Swab 184 oil in 4 hours.
4/2	" " " "
	-
4/9	Arb. 3317'
	4" - 3318'
	T.D. 3327'
	6000 acid.
	Depthograph potential 2460 oil
	& 540 water.
	39. Gravity
	COMPLETED

Map No. 73 Sec. 5 Twp. 16 R. 13W

Well No. 14 Bitter "B"

Shell Company

FIRST REPORT

Contractor

'NW SW

SECTION PLAT

330 Ft. from N. Line

_____ Ft. from S. Line

_____ Ft. from E. Line

435 Ft. from W. Line

TRAPP POOL

o			

Location _____

Rig up _____

Drilling and Remarks:

Drlg. 260

RECORD

Cased _____ in., _____ ft.

Sand _____

Gas _____

Oil _____

Total Depth _____

PRODUCTION

1st 24 hrs. Nat. _____

1st 24 hrs. after shot _____

Gas _____ Cu. Ft.

Dry Hole _____

Abandoned _____

Date

MAR 5 1941 19

S. J. LEWIS

Scout

Map No. 73 Sec. 5 Twp. 16 R. 13WWell No. 14 Bitter "B"Shell Oil

Company

COMPLETED

Contractor

SECTION PLAT

NW SW

330 Ft. from N. Line

_____ Ft. from S. Line

_____ Ft. from E. Line

435 Ft. from W. Line

o			

TRAPP POOL

Location _____

Rig up _____

Drilling and Remarks:

*Cor 3317**4" @ 3318**6000 accl**Depth 3460 ml**540 Water**39° Gr***RECORD**

Cased _____ in., _____ ft.

Sand _____

Gas _____

Oil _____

Total Depth: 3327**PRODUCTION**

1st 24 hrs. Nat. _____

1st 24 hrs. after shot _____

Gas _____ Cu. Ft.

Dry Hole _____

Abandoned _____

Date

APR 9 1941 19

S. J. LEWIS Scout