


Section 11 Township 30 Range 4-E

Well Number 4-Joslin (*Isiah Joslin*)

Company Shawver

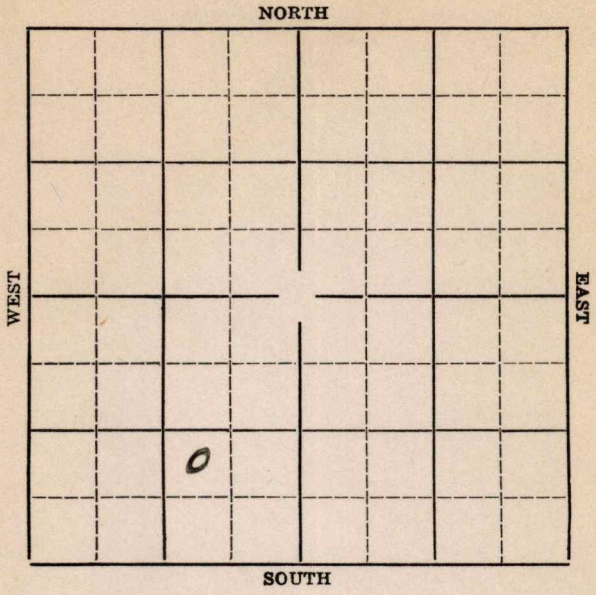

Map No. **KANSAS** Sec. **11** Twp. **30** R. **4E**

Well No. **#4 Joslin** Farm


Shawver Company

Ft. from N. Line

990' Ft. from S. Line

990' Ft. from E. Line

Ft. from W. Line

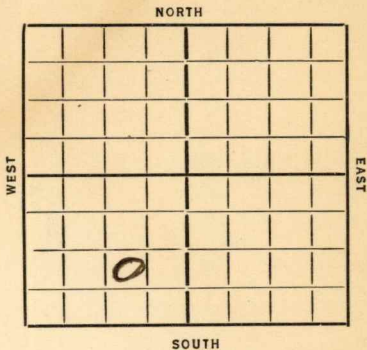

Elev. 1188

1936

REPORT

6/10 Location

6/18--

6/25 Ponds.

7/2--

7/9 Drlg. 200'.

7/16 Run 13" @ 80l&.

7/23 Drlg. 11020'.

7/30 Drlg. 1512'.

8/6 Drlg. 1845'.

8/13 Drlg. 2015'.

8/20 Kansas City 2288'. Drlg. 2380'.

8/27 Bart. sand 2715'. Show oil and gas. 2730'. Drg.

9/3 T.D. 2779'. Testing.

9/16 Bart. sd. 2711 T.D. 2779 8 bbls.

COMPLETED

Cowley
Map No. 11 Sec. 11 Twp. 30 R. 4E

AMISAS

Well No. 4 Joslin
Shawnee Company

Contractor

SECTION PLAT

_____ Ft. from N. Line
990 Ft. from S. Line
990 Ft. from E. Line
_____ Ft. from W. Line

	o		

FIRST REPORT

Location ✓

Rig up _____

Drilling and Remarks:

RECORD

Cased _____ in., _____ ft.
Sand _____
Gas _____
Oil _____
Total Depth _____

PRODUCTION

1st 24 hrs. Nat. _____
1st 24 hrs. after shot _____
Gas _____ Cu. Ft.
Dry Hole _____
Abandoned _____

Date

JUN 10 1936

S. J. LEWIS

Scout

KANSAS

Map No. 10 Sec. 11 Twp. 30 R. 4E

Well No. 4 Joslin

Shawnee Company

Contractor

SECTION PLAT

	o		

_____ Ft. from N. Line

990 Ft. from S. Line

990 Ft. from E. Line

_____ Ft. from W. Line

COMPLETED

Location _____

Rig up _____

Drilling and Remarks:

Bart. sol.

2711 -

8 Bxls.

RECORD

Cased _____ in., _____ ft.

Sand _____

Gas _____

Oil _____

Total Depth 2729

PRODUCTION

1st 24 hrs. Nat. _____

1st 24 hrs. after shot _____

Gas _____ Cu. Ft.

Dry Hole _____

Abandoned _____

Date

SEP 16 1936 19

S. J. LEWIS Scout