


Section 1 Township 15 Range 14W

Well No. #7 Michel "A"

Company N C R A

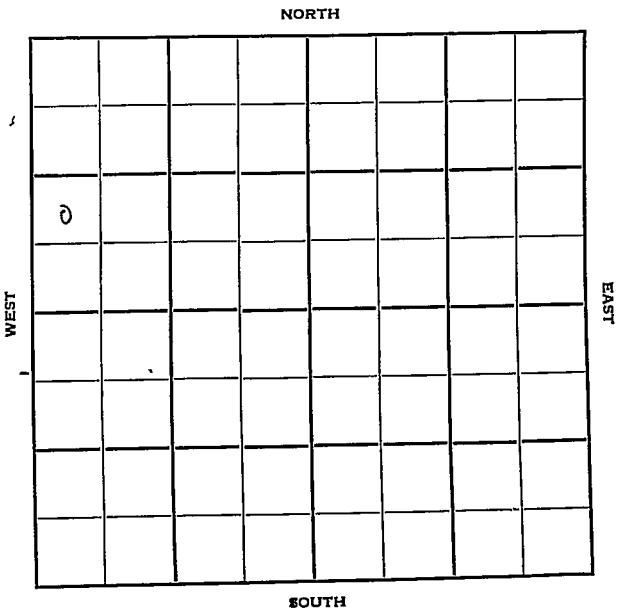

Sec. 1 Twp. 15 R. 14W

Well No. #7 Michel "A" Farm _____

NCRA

Company _____


Trapp Pool (Wakefield, Contr^{NORTH})

_____ Ft. from N. Line

990' Ft. from S. Line

_____ Ft. from E. Line

330' Ft. from W. Line

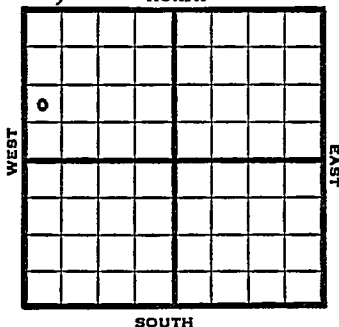

NW SW NW

1949

Elev 1700' REPORT

11/23 Rig
11/29 15" @ 63'
13" @ 350'
Drlg 560'
12/7 10" @ 687'
Drlg 1675'
12/14 Drlg. 2250'
12/21 8" @ 2444'
Lans ng 2903' Drlg
12/28 7" @ 3060' GO
3/15 TD 3206'
15" @ 63'
10" @ 687'
5" @ 3186'
Dodge 2836'
KC 3104'
Cong 3153'
Arb. 3186'
Plug back to 2920'
Perf 12/2912-19
22 BOPD
Comp

COMPLETED

Map No. _____ Sec. 1 Twp. 15 R. 14W

Well No. 7 Michel "A"

N C R A Company

Wakefield Contractor

NW SW NW

**FIRST REPORT
SECTION PLAT**

_____ Ft. from N. Line

990 Ft. from S. Line

_____ Ft. from E. Line

330 Ft. from W. Line

o			

Russell County

Location _____

Rig up _____

Drilling and Remarks:

Rig _____

RECORD

Cased _____ in., _____ ft.

Sand _____

Gas _____

Oil _____

Total Depth _____

PRODUCTION

1st 24 hrs. Nat. _____

1st 24 hrs. after shot _____

Gas _____ Cu. Ft.

Dry Hole _____

Abandoned _____

Date

NOV 23 1949 19

S. J. LEWIS

Scout

Kansas

Map No. _____ Sec. 1 Twp. 15 R. 14W

Well No. 7 Michel "A"

N C R A

Company _____

Contractor _____

NW SW NW

EI. 1700
SECTION PLAT

_____ Ft. from N. Line

990 Ft. from S. Line

_____ Ft. from E. Line

330 Ft. from W. Line

o	COMPLETE		

Russell County

Location _____

Rig up _____

Drilling and Remarks:

15" @ 63
10" @ 687
5" @ 3186
Dodge 2836
K.C. 3104
Org 3153
and 3186

RECORD

Cased _____ in., _____ ft.

Sand _____

Gas _____

Oil _____

Total Depth 3206

PRODUCTION

1st 24 hrs. Nat. _____

1st 24 hrs. after shot _____

Gas _____ Cu. Ft.

Dry Hole _____

Abandoned _____

Plug Back to 2920

Date prof 12/29/12-19

22 BOPD

MAR 15 1950

J. E. TYRA Scout