

Cowley

KANSAS ✓

Sec. 11 Twp. 30 R. 4E

Well No. #44 Rock Unit Farm _____

Stelbar Oil Company _____

Contractor _____

Rock Pool


Ft. from N. Line

300 Ft. from S. Line

Ft. from E. Line

1100 Ft. from W. Line

SE SW SW

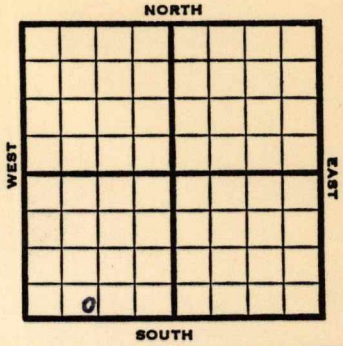

1953 **Elev. 1206'** REPORT

7/1 Spud 6-23-53
8" @ 71'
Drlg. 1778'

7/15 Spud 6-23-53
Oil Well
TD 2775'
8" @ 71'
KC 2202, Bart 2758
TD 2775'
5" @ 2761'
CO to 2775'
Comp. Waiting on water flood.

COMPLETED

