


Section 11 Township 30 Range 4 E

Well No. # 45 Rock Unit

Company Stelbar

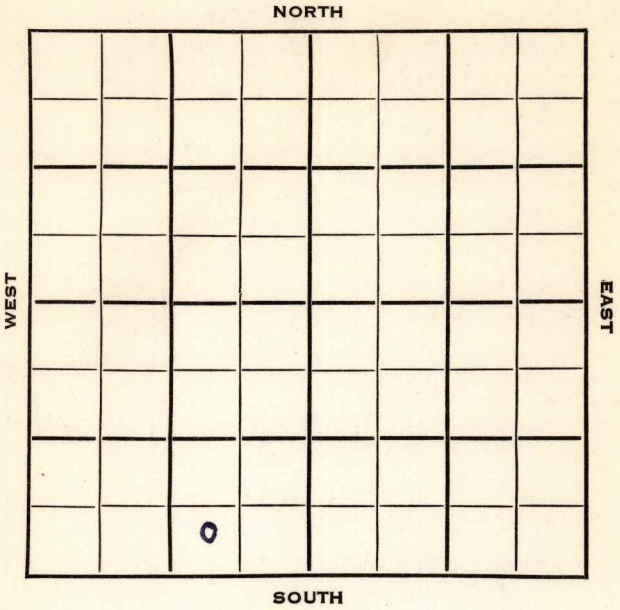

Cowley

KANSAS

Sec. 11 Twp. 30 R. 4 E

Well No. # 45 Rock Unit Farm

Stelbar Company

Stelbar Contractor


_____ Ft. from N. Line

460 Ft. from S. Line

840 Ft. from E. Line

_____ Ft. from W. Line

SW SE SW

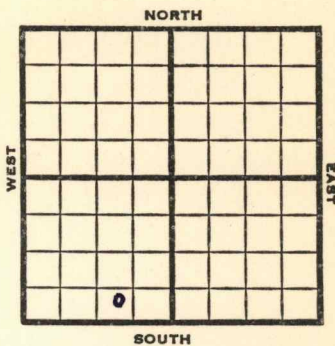

1953

Elev. 1220' REPORT

8/5

Spud 8-5-53

9/23

Spud 8-5-53 Input well TD 2768
 8" @ 50 **Bart 2752** TD 2768
 5" @ 2752 OO to 2768 PB 2763
 Comp. for water flood input

ABANDONED

