


Cowley

Map No. *Kansas* Sec. *29* Twp. *33* R. *3*

Well No. *4 Beatty (Beebe)* Farm

White Phillips Company

NORTH

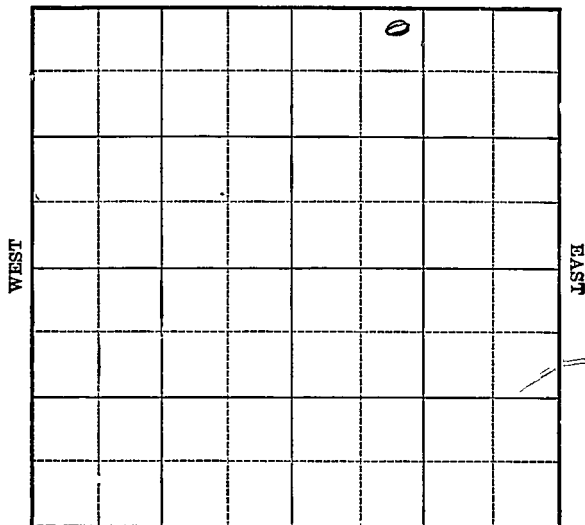

SOUTH

Location _____

Drilling Remarks _____

Rig Up _____

Drilling Remarks _____

RECORD

Cased _____ in. _____ ft.

Sand _____

Gas _____

Oil _____

Total Depth _____

PRODUCTION

1st 24 hrs. Nat. _____

1st. 24 hrs. after shot _____

Gas _____ cu. ft.

Dry Hole _____

Abandoned _____

Cowley

Map No. Kansas Sec. 29 Twp. 33 R. 3

Well No. 4 Beatty Farm


Waite Phillips Company

330 Ft. from N. Line

..... Ft. from S. Line

..... Ft. from E. Line

990 Ft. from W. Line

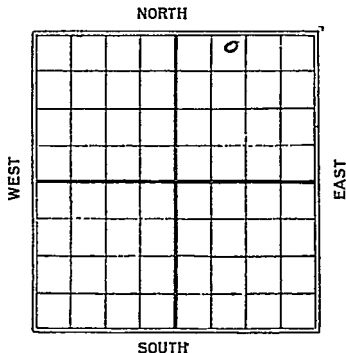

Date	REPORT
1925	
3/1	Location
6/5	# 3232 - F.O. 3245 - B.S. 3263 - T.D.
	3264 shot 20 ft level 65 lbs

1

Well No. 4 *Beathes* Farm
Walter Phillips Company

990' x 330' N

					0	
		FIRST REPORT				

W
Location *vv*.....
Rig up.....
Drilling and Remarks.....

S
RECORD
Casedin.....ft.
Sand.....
Gas.....
Oil.....
Total Depth.....

PRODUCTION
1st 24 hrs. Nat.....
1st 24 hrs. after Shot....
Gascu. ft.
Dry Hole.....
Abandoned

Date *3/1* 19*25*

M. A. BENEAR Scout

Map No. **KANSAS** Sec. **29** Twp. **33** R. **3**

Well No. **4 Beath**

Watts Phillips Company

Contractor

COMPLETED SECTION PLAT

330 Ft. from N. Line

_____ Ft. from S. Line

_____ Ft. from E. Line

990 Ft. from W. Line

		0	

Location _____

Rig up _____

Drilling and Remarks:

*Tap 0.3232
70. 3245
Bottom 0.3263
T.D. 3264
shot 20 g to*

RECORD

Cased _____ in., _____ ft.

Sand _____

Gas _____

Oil _____

Total Depth _____

PRODUCTION

1st 24 hrs. Nat. _____

1st 24 hrs. after shot _____

Gas _____ Cu. Ft.

Dry Hole _____

Abandoned _____

swapping 65 bell

Date

JUN 5 1925

192

M. A. BENEAR

Scout