

KANSAS

Form 51-5M-7-39-Palace


Cowley

Section 11 Township 30 Range 4-E

Well No. #1 Widener

Company E. B. Shawver

NORTH Rock Pool

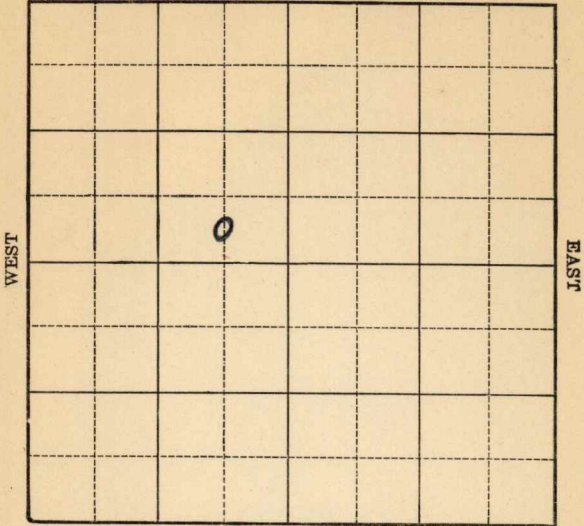

SOUTH

Sec. 11 Twp. 30 R. 4-E

Well No. #1 Widener Farm

E. B. Shawver Company

(Rock)


_____ Ft. from N. Line

330 Ft. from S. Line

660 Ft. from E. Line

_____ Ft. from W. Line

Elev. 1198

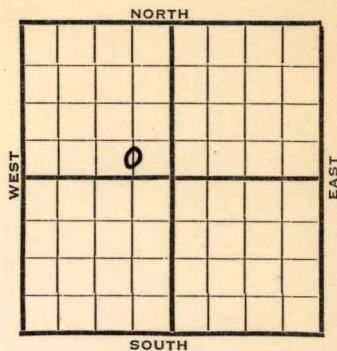

1940	REPORT
3/27	12" - 39' Drlg. 1300'
4/4	8" - 2710' WOC.
4/12	" " "
4/18	Miss. 2825' T.D. 2840' C.O.
4/25	T.D. 3021' SD.
5/2	" " "
5/9	7" - 3025' SD.
5/16	" " "
5/23	" " "
5/29	" " "
6/6	Arb. 3226' Oil 3226-30' T.D. 3245' S.W.
6/13	" " "
6/19	Miss. 3125' Arb. 3226' T.D. 3245' No shows.
	ABANDONED

Map No. 11 Sec. 11 Twp. 30 R. 4E

Well No. 1 Widener

E. B. Shawver Company

Contractor

ABANDONED

SECTION PLAT

C S L SE NW

 Ft. from N. Line

330 Ft. from S. Line

660 Ft. from E. Line

 Ft. from W. Line

ROCK POOL

Location

Rig up

Drilling and Remarks:

Miss 3125

Co 83226.

No shows

RECORD

Cased in., ft.

Sand

Gas

Oil

Total Depth 3245

PRODUCTION

1st 24 hrs. Nat.

1st 24 hrs. after shot

Gas Cu. Ft.

Dry Hole

Abandoned

Date

JUN 19 1940 19

S. J. LEWIS Scout

Map No. // Sec. 11 Twp. 30 R. 4E

Well No. 1 Widener

E. B. Shawver Company

Contractor

FIRST REPORT

SECTION PLAT

C S L SE NW

Ft. from N. Line

330 Ft. from S. Line

660 Ft. from E. Line

Ft. from W. Line

ROCK POOL

Location _____

Rig up _____

Drilling and Remarks:

12" - 39

1300 Dr1g.

RECORD

Cased _____ in., _____ ft.

Sand _____

Gas _____

Oil _____

Total Depth _____

PRODUCTION

1st 24 hrs. Nat. _____

1st 24 hrs. after shot _____

Gas _____ Cu. Ft.

Dry Hole _____

Abandoned _____

Date

MAR 27 1940₁₉

S. J. LEWIS Scout