


Section 11 Township 30 Range 4E

Well No. #1 Joslin "C"

Company Stelbar

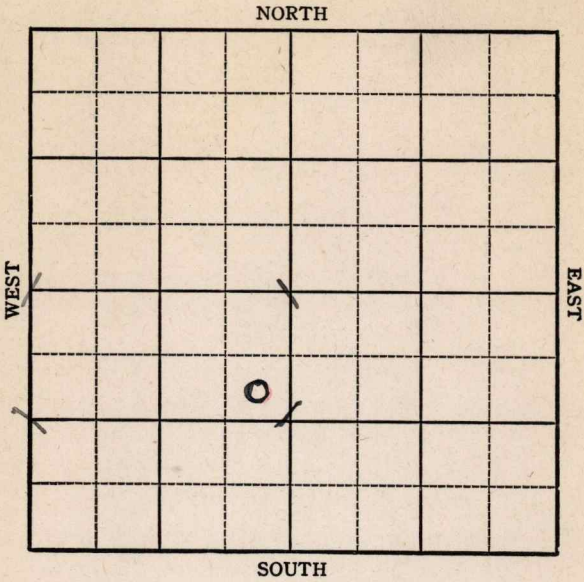

Sec. 11 Twp. 30 R. 4E

Well No. #1 Joslin "C" Farm

Stelbar Company


Miscellaneous

990 Ft. from N. Line

_____ Ft. from S. Line

330 Ft. from E. Line

_____ Ft. from W. Line

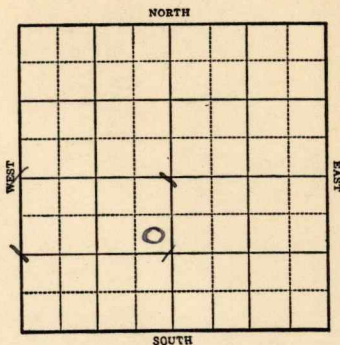

1944

ELEV. 1195 R E P O R T

3/8 10" @ 36'
Drilling 345'

3/16 Drilling 2450'

3/22 **KC 2234**
7" @ 2782 2703
TD 2795
Rust

3/29 7" @ 2703 corrected.

4/5 " " " "

4/12 " " " "

4/19 " " " "

4/26 " " " 2"

5/3 " 2" " "

5/10 " " " "

5/17 " " " "

OVER

1944
5/31

Bart 2703
7" @ 2703
TD 2729
60 qts 2705-24
Pump 40 Pot.
Grav. 38.2

COMPLETED

Pool Name Miscellaneous

KANSAS

Map No. 11 Sec. 11 Twp. 30 R. 4E

Well No. 1 Joslin "C"

Stelbar Company

COMPLETED Contractor

SE NE SW

SECTION PLAT

990 Ft. from N. Line

_____ Ft. from S. Line

330 Ft. from E. Line

_____ Ft. from W. Line

Cowley County

Location _____

Rig up _____

Drilling and Remarks:

Bar 2703
7" 2703
609 to 2705-24
Pump 40 Pst

383 1/2

RECORD

Cased _____ in., _____ ft.

Sand _____

Gas _____

Oil _____

Total Depth 2729

PRODUCTION

1st 24 hrs. Nat. _____

1st 24 hrs. after shot _____

Gas _____ Cu. Ft.

Dry Hole _____

Abandoned _____

Date

MAY 31 1944 19 _____

S. J. LEWIS Scout