


Cowley

Map No. Kansas Sec. 11 Twp. 30 R. 4

Well No. 2 Widener Farm

Shawver & Sutter Company

NORTH

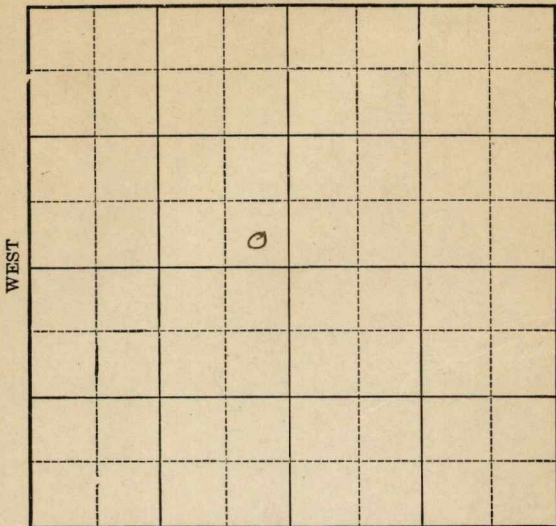

WEST

EAST

SOUTH

Location \_\_\_\_\_

Drilling Remarks \_\_\_\_\_  
\_\_\_\_\_  
\_\_\_\_\_  
Rig Up \_\_\_\_\_

Drilling Remarks \_\_\_\_\_  
\_\_\_\_\_  
\_\_\_\_\_  
**RECORD**

Cased \_\_\_\_\_ in. \_\_\_\_\_ ft.

Sand \_\_\_\_\_

Gas \_\_\_\_\_

Oil \_\_\_\_\_

Total Depth \_\_\_\_\_

**PRODUCTION**

1st 24 hrs. Nat. \_\_\_\_\_

1st 24 hrs. after shot \_\_\_\_\_

Gas \_\_\_\_\_ cu. ft.

Dry Hole \_\_\_\_\_


Abandoned \_\_\_\_\_

Cowley

Map No. 15A Sec. 11 Twp. 30 R. 4

Well No. 2 Widener Farm  
Shawver & Sutter Company

NORTH

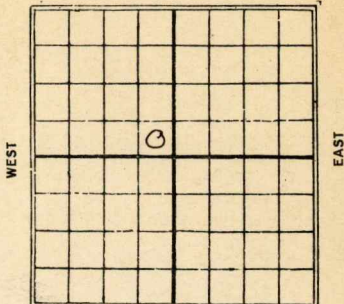

..... Ft. from N. Line

330 Ft. from S. Line

330 Ft. from E. Line

..... Ft. from W. Line

1926

Date	REPORT
------	--------

8/4	Spudding
-----	----------

8/11	Drg 250
------	---------

8/18	same
------	------

8/25	log took 1750
------	---------------

8/31	
------	--

9/15	Drg 2290
------	----------

9/22	" 2440
------	--------

9/29	same
------	------

10/13	same
-------	------

10/27	5 barrel show 2726-71 Topline 2845' 2A 3045'
-------	---

	will plug back to 2771'
--	-------------------------

11/3	5 bbl show 2726-71
------	--------------------

	J.L. 2845'
--	------------

	D.O.A. 3045'
--	--------------

*Cowley*

Map No. **KANSAS** Sec. *11* Twp. *30* R. *4*

Well No. *2* *Wideman*  
*Shawyer & Butler* Company

Contractor

**FIRST REPORTS**

**SECTION PLAT**

----- Ft. from N. Line  
*330*  
 ----- Ft. from S. Line  
*330*  
 ----- Ft. from E. Line  
 ----- Ft. from W. Line

		o	

Location -----

Rig up -----

Drilling and Remarks:

*Spudding*

**RECORD**

Cased ----- in., ----- ft.  
 Sand -----  
 Gas -----  
 Oil -----  
 Total Depth -----

**PRODUCTION**

1st 24 hrs. Nat. -----  
 1st 24 hrs. after shot -----  
 Gas ----- Cu. Ft.  
 Dry Hole -----  
 Abandoned -----

Date

**AUG 4 1926**

**CHAS. L. SHERWOOD**

192

Scout

11 **KANSAS** Sec. 11 Twp. 30 R. 4  
Well No. 2 Widenor  
Shawyer & Sutton Company

Contractor

**COMPLETED**

**SECTION PLAT**

----- Ft. from N. Line  
330 Ft. from S. Line  
330 Ft. from E. Line  
----- Ft. from W. Line


**ABANDONED**

Location -----

Rig up -----

Drilling and Remarks:

5 88 show 2726-71

TL 2845

Dry 3045

**RECORD**

Cased ----- in., ----- ft.  
Sand -----  
Gas -----  
Oil -----  
Total Depth 3045

**PRODUCTION**

1st 24 hrs. Nat. -----  
1st 24 hrs. after shot -----  
Gas ----- Cu. Ft.  
Dry Hole   
Abandoned

Date **NOV 3 1926**

*Cowley*  
K11 **KANSAS** SEC. *11* TWP. *30S* R. *4E*

WELL NO. *2 Widener*  
*Shawver & Butte* COMPANY

CONTRACTOR

**ABANDONED**

**SECTION PLAT**

\_\_\_\_\_ FT. FROM N. LINE  
\_\_\_\_\_ FT. FROM S. LINE  
\_\_\_\_\_ FT. FROM E. LINE  
\_\_\_\_\_ FT. FROM W. LINE

		6	

LOCATION \_\_\_\_\_

RIG UP \_\_\_\_\_

DRILLING AND REMARKS:

*see plan 3045*

**RECORD**

CASED \_\_\_\_\_ IN., \_\_\_\_\_ FT.  
SAND \_\_\_\_\_  
GAS \_\_\_\_\_  
OIL \_\_\_\_\_  
TOTAL DEPTH *2876*

**PRODUCTION**

1ST 24 HRS. NAT. \_\_\_\_\_  
1ST 24 HRS. AFTER SHOT \_\_\_\_\_  
GAS \_\_\_\_\_ Cu. Ft.  
DRY HOLE   
ABANDONED

DATE

*15/27* 192 *6*

SCOUT