


Cowley

KANSAS 3E

Section 29 Township 33 Range 3E

Well No. 1 Moldenhauer

Company K. T. Weidemann

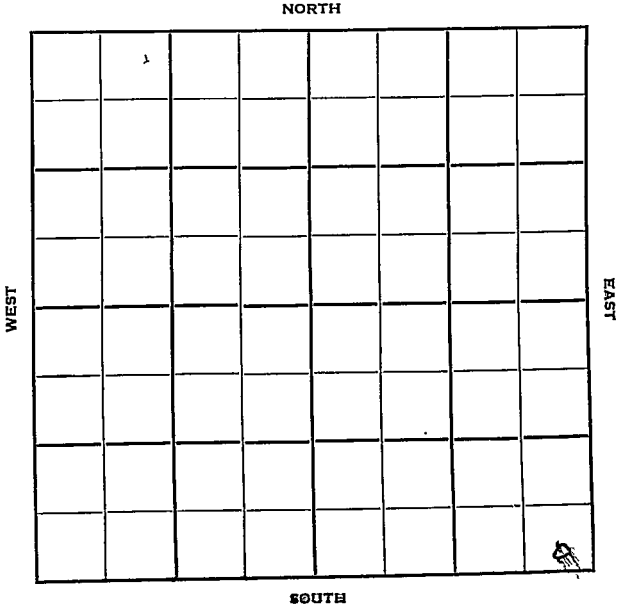

KANSAS ✓

Sec. 29 Twp. Gowley 33 R. 3E

Well No. #1 Moldenhauer Farm

K. T. Weidemann Company

Contractor


Ft. from N. Line

330 Ft. from S. Line

330 Ft. from E. Line

Ft. from W. Line

SE SE SE

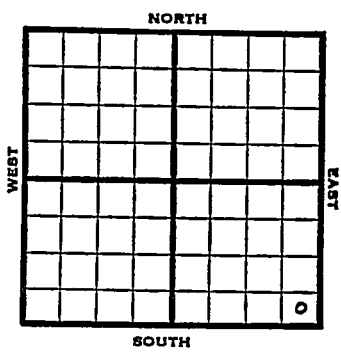

1952 Elev. 1114' REPORT

12/17 Setting Surface

1953

2/4 Spud 1-4-53

D&A

TD 3316

8" @ 93

Lans 2809, Bart 3298

TD 3301

5" @ 3298

DD 3316, PB 3314, sd-frac

wtr & SO

D&A

ABANDONED

