


Section 11 Township 30 Range 4-E

Well No. 1 Wilson

Company E. B. Shawver

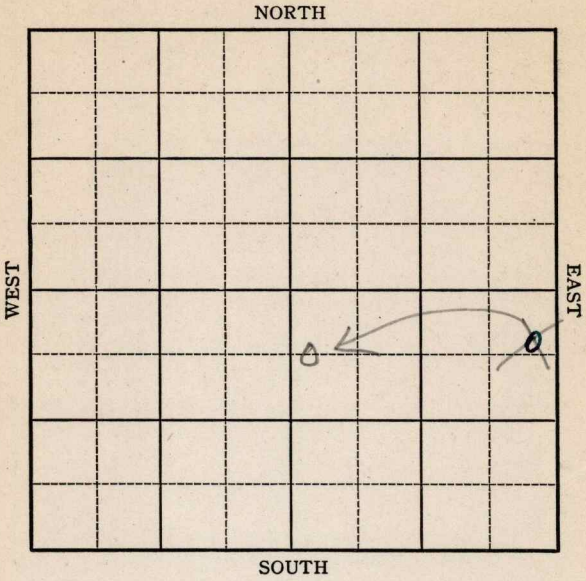



Map No. // Sec. 11 Twp. 30 R. 4E

Well No. 1 Wilson

E. B. Shawver Company

Contractor

FIRST REPORT

SECTION PLAT


C E L N E S E

520 Ft. from N. Line

Ft. from S. Line

250 Ft. from E. Line

250 Ft. from W. Line

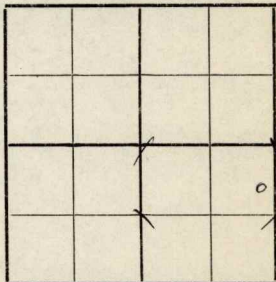

ROCK POOL

Location X

Rig up

Drilling and Remarks:

RECORD

Cased in., ft.

Sand

Gas

Oil

Total Depth

PRODUCTION

1st 24 hrs. Nat.

1st 24 hrs. after shot

Gas Cu. Ft.

Dry Hole

Abandoned

Date

JUL 9 1941

19

S. J. LEWIS

Scout

KANSAS

Map No. 11 Sec. 11 Twp. 30 R. 4E

Well No. 1 Wilson

E. B. Shawver Company

CORRECTION Contractor

C W L N E S E

SECTION PLAT

520 Ft. from N. Line

\_\_\_\_\_ Ft. from S. Line

\_\_\_\_\_ Ft. from E. Line

250 Ft. from W. Line

		0	

ROCK POOL

RECORD

Location \_\_\_\_\_

Cased \_\_\_\_\_ in., \_\_\_\_\_ ft.

Rig up \_\_\_\_\_

Sand \_\_\_\_\_

Drilling and Remarks:

Gas \_\_\_\_\_

Oil \_\_\_\_\_

Reported

Total Depth \_\_\_\_\_

PRODUCTION

C E L N E S E

1st 24 hrs. Nat. \_\_\_\_\_

1st 24 hrs. after shot \_\_\_\_\_

Gas \_\_\_\_\_ Cu. Ft.

Dry Hole \_\_\_\_\_

Abandoned \_\_\_\_\_

Date

AUG 6 1941

19

S. J. LEWIS

Scout

Map No. 11 Sec. 11 Twp. 30 R. 4E

Well No. 1 Wilson

E. B. Shawver Company

COMPLETED Contractor

SECTION PLAT

C W L N E S E

520 Ft. from N. Line

\_\_\_\_\_ Ft. from S. Line

\_\_\_\_\_ Ft. from E. Line

250 Ft. from W. Line

		0	

ROCK POOL

Location \_\_\_\_\_

Rig up \_\_\_\_\_

Drilling and Remarks:

*Bar 2720*

*7" @ 2700.*

*40 gts 2730-36*

*Pump 143 2d*

*40 gts*

RECORD

Cased \_\_\_\_\_ in., \_\_\_\_\_ ft.

Sand \_\_\_\_\_

Gas \_\_\_\_\_

Oil \_\_\_\_\_

Total Depth 2744

PRODUCTION

1st 24 hrs. Nat. \_\_\_\_\_

1st 24 hrs. after shot \_\_\_\_\_

Gas \_\_\_\_\_ Cu. Ft.

Dry Hole \_\_\_\_\_

Abandoned \_\_\_\_\_

Date

AUG 20 1941 19

S. J. LEWIS Scout