

# KANSAS


Cowley

Section 30 Township 33 Range 3E

Well No. #2 Holman

Company Dunn & Strait

NORTH

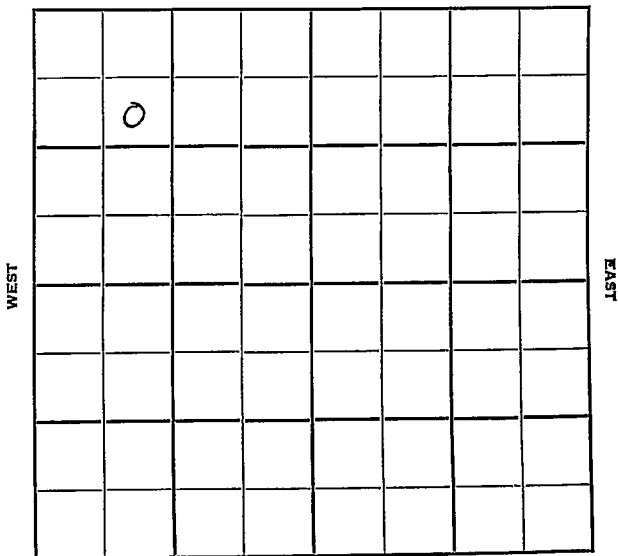

SOUTH

WEST

EAST

Cowley ✓

Sec. 30 Twp. 33 R. 3-E

Well No. #2 Holman Farm \_\_\_\_\_

Dunn & Strait Company \_\_\_\_\_

Cont— Dunn & Strait

Miscellaneous


990 Ft. from N. Line

\_\_\_\_\_ Ft. from S. Line

\_\_\_\_\_ Ft. from E. Line

990 Ft. from W. Line

SE NW NW

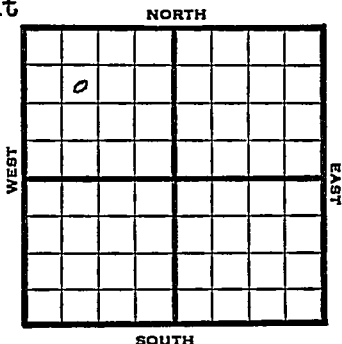

1949 Elev. 1100' REPORT

10/12 8" @ 138'  
Drlg 800'

10/19 Drlg 2340'

10/26 KC 2724'  
Miss 3195'  
Drlg. 3325'

11/1 Simpson 3517(  
TD 3536  
5" @ 3520'

11/9 TD 3556'  
Arb. 3549'  
Aband.

**ABANDONED**

Map No. \_\_\_\_\_ Sec. 30 Twp. 33 R. 3E

Well No. '2 Holman

\_\_\_\_\_ Dunn & Strait \_\_\_\_\_ Company

\_\_\_\_\_ Dunn & Strait \_\_\_\_\_ Contractor

SE NW NW

**FIRST REPORT  
 SECTION PLAT**

990 Ft. from N. Line

\_\_\_\_\_ Ft. from S. Line

\_\_\_\_\_ Ft. from E. Line

990 Ft. from W. Line


Cowley County

Location \_\_\_\_\_

Rig up \_\_\_\_\_

Drilling and Remarks:

8" @ 138

drlg. 800

**RECORD**

Cased \_\_\_\_\_ in., \_\_\_\_\_ ft.

Sand \_\_\_\_\_

Gas \_\_\_\_\_

Oil \_\_\_\_\_

Total Depth \_\_\_\_\_

**PRODUCTION**

1st 24 hrs. Nat. \_\_\_\_\_

1st 24 hrs. after shot \_\_\_\_\_

Gas \_\_\_\_\_ Cu. Ft.

Dry Hole \_\_\_\_\_

Abandoned \_\_\_\_\_

Date

OCT 12 1949 19

S. J. LEWIS Scout

Map No. \_\_\_\_\_ Sec. 30 Twp. 33 R. 3E

Well No. 2 Holman

\_\_\_\_\_ Dunn & Strait \_\_\_\_\_ Company

\_\_\_\_\_ ABANDONED \_\_\_\_\_ Contractor

SE NW NW

*E. 1100*  
SECTION PLAT

990 Ft. from N. Line

\_\_\_\_\_ Ft. from S. Line

\_\_\_\_\_ Ft. from E. Line

990 Ft. from W. Line

o			

Cowley County

Location \_\_\_\_\_

Rig up \_\_\_\_\_

Drilling and Remarks:

*See 83549*

**RECORD**

Cased \_\_\_\_\_ in., \_\_\_\_\_ ft.

Sand \_\_\_\_\_

Gas \_\_\_\_\_

Oil \_\_\_\_\_

Total Depth 25.56

**PRODUCTION**

1st 24 hrs. Nat. \_\_\_\_\_

1st 24 hrs. after shot \_\_\_\_\_

Gas \_\_\_\_\_ Cu. Ft.

Dry Hole \_\_\_\_\_

Abandoned \_\_\_\_\_

Date

NOV 9 1949

19

S. J. LEWIS

Scout