


Section 11 Township 30 Range 4E

Well No. 3 Wilson "A "

Company Stelbar

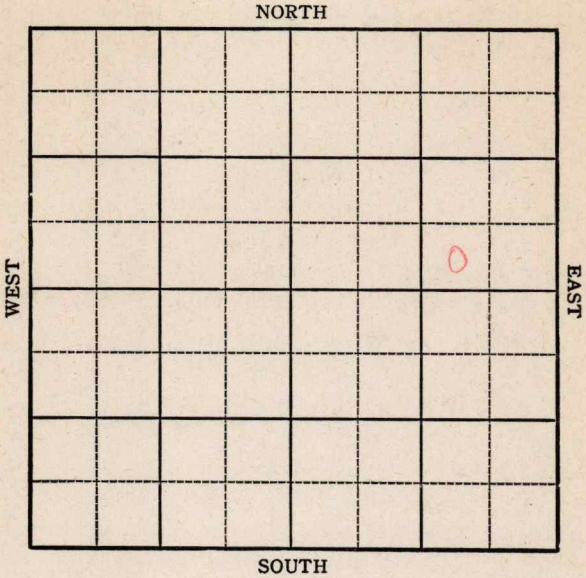

KANSAS

Cowley

Sec. 11 Twp. 30 R. 4E

Well No. 3 Wilson "A" Farm

Stelbar Company

Miscellaneous


 Ft. from N. Line

330 Ft. from S. Line

990 Ft. from E. Line

 Ft. from W. Line

SW SE NE

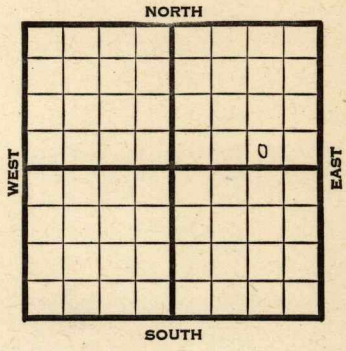

1945 **Elev. ?** REPORT

5/23 10" -44'
840'

5/31 **KC 2190**
Drig. 2655

6/8 **Bart 2735- 36 TD 7" @ 2732**
RUST

6/20 **Bart. 2735**
7" @ 2732
Miss. 2820
TD 2831'

ABANDONED

Kansas Pool Name Miscellaneous

Map No. 11 Sec. 11 Twp. 30 R. 4E

Well No. 3 Wilson "A"

Stelbar Company

FIRST REPORT Contractor

SW SE NE

SECTION PLAT

 Ft. from N. Line

330 Ft. from S. Line

990 Ft. from E. Line

 Ft. from W. Line

			a

Cowley

Location

Rig up

Drilling and Remarks:

10" - 44'

840'

RECORD

Cased in., ft.

Sand

Gas

Oil

Total Depth

PRODUCTION

1st 24 hrs. Nat.

1st 24 hrs. after shot

Gas Cu. Ft.

Dry Hole

Abandoned

Date

MAY 23 1945

19

S. J. LEWIS

Scout

Kansas Pool Name Miscellaneous

Map No. _____ Sec. 11 Twp. 30 R. 4E

Well No. 3 Wilson "A"

Stelbar Company

ABANDONED Contractor

SW SE NE

SECTION PLAT

_____ Ft. from N. Line

330 Ft. from S. Line

990 Ft. from E. Line

_____ Ft. from W. Line

Cowley County

RECORD

Location _____

Cased _____ in., _____ ft.

Rig up _____

Sand _____

Drilling and Remarks:

Gas _____

Bar 2235

Oil _____

3" @ 2732

Total Depth 2831

Miss 2820

PRODUCTION

1st 24 hrs. Nat. _____

1st 24 hrs. after shot _____

Gas _____ Cu. Ft.

Dry Hole _____

Abandoned _____

Date

JUN 20 1945 19 _____

S. J. LEWIS Scout