

Section 30 Township 33 Range 3E

Well No. 1 Yarnell

Company Dunn & Strait

Misc.
NORTH

A 10x10 grid map. The word "WEST" is written vertically on the left side, "EAST" on the right side, and "SOUTH" at the bottom center. A small letter "D" is located in the top-left cell of the grid.

Cowley KANSAS

Sec. 30 Twp. 33 R. 3E

Well No. #1 Yarnell Farm

Dunn & Strait Company

Miscellaneous


330' Ft. from N. Line

Ft. from S. Line

Ft. from E. Line

330' Ft. from W. Line

NW/C

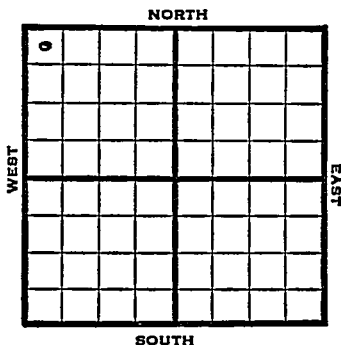

1949 Elev. 1110' REPORT

5/4 Location

5/10 8" @ 140'
Drlg. 1140'
5/18 Topeka 1450'
Stahaker 2178'
Layton 3572'
Drlg 2735'

5/25 Miss 3198'
Drlg. 3327'

6/1 "

6/7 TD 3524'
40 qts 3516-24
5 bbls oil PH

6/15 "

6/22 Simp 3511'
5" @ 3512'
40 qts
Pump 25 oil Pot.
Gr. 440
TD 3524'

COMPLETED

Kansas

Map No. _____ Sec. 30 Twp. 33 R. 3EWell No. 1 YarnellDunn & Strait


Company

FIRST REPORT

Contractor

NW/C

SECTION PLAT

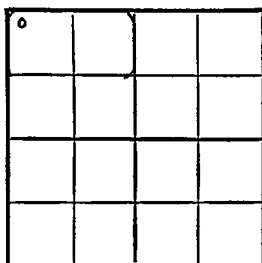330 Ft. from N. Line

_____ Ft. from S. Line

_____ Ft. from E. Line

330 Ft. from W. Line

Cowley County

RECORD

Location X

Cased _____ in., _____ ft.

Rig up _____

Sand _____

Drilling and Remarks: _____

Gas _____

Oil _____

Total Depth _____

PRODUCTION

1st 24 hrs. Nat. _____

1st 24 hrs. after shot _____

Gas _____ Cu. Ft.

Dry Hole _____

Abandoned _____

Date

MAY 4 1949 19S. J. LEWIS

Scout

Kansas

Miscellaneous

Map No. K1 Sec. 30 Twp. 33 R. 3EWell No. 1 YarnellDunn & Strait

Company

COMPLETE

Contractor

NW/C

E1110
SECTION PLAT330 Ft. from N. Line

Ft. from S. Line

Ft. from E. Line

330 Ft. from W. Line

6			

Cowley County

RECORD

Location

Cased _____ in., _____ ft.

Rig up

Sand

Drilling and Remarks:

Gas

Oil

Total Depth 2524

PRODUCTION

1st 24 hrs. Nat. _____

1st 24 hrs. after shot _____

Gas _____ Cu. Ft.

Dry Hole _____

Abandoned _____

Date

JUN 22 1949

19

S. J. LEWIS

Scout