KANSAS

Russell


FORM 51 5M 10-41 PETROL

Section 6 Township 15 Range 14-W

Well No. #1 Mitchel

Company Max Cohen et al

Big Creek Pool

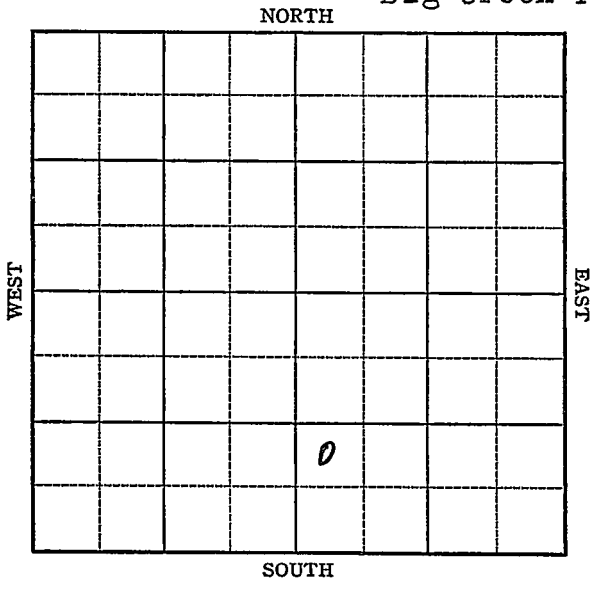

FORM 252 A
5M 10-41 PETROL

KANSAS

Russell

Sec. 6 Twp. 15 R. 14-W

Well No. #1 Mitchel Farm

Max Cohen et al Company


(Big Creek)

____ Ft. from N. Line

990 Ft. from S. Line

____ Ft. from E. Line

330 Ft. from W. Line

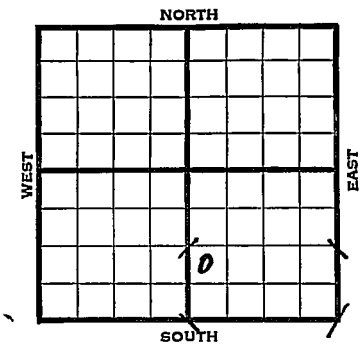

Elev. 1752

1942	REPORT
4/1	10" - 262' Anhy. 756'
	Drlg. 1130'
4/8	Drlg. 2895'
4/15	Tarkio 2406' Howard 2416'
	Topeka 2673' Lans. 2959'
	7" - 2959' Drlg. 3075' No shows.
4/22	Cong. 3200' Gorham 3217' Arb. 3225'
	Drlg. 3239' 278' of 5" liner at 3226'
4/29	Arb. 3225'
	T.D. 3255'
	Water.
	ABANDONED

Form 26 200 Bks 5-41 McW.

Russell KANSAS

Map No. 73 Sec. 6 Twp. 15 R. 14W

Well No. 1 Mitchel

Max Cohen etal. Company

~~FIRST REPORT~~ Contractor

NW SW SE


____ Ft. from N. Line

990 Ft. from S. Line

____ Ft. from E. Line

330 Ft. from W. Line

SECTION PLAT

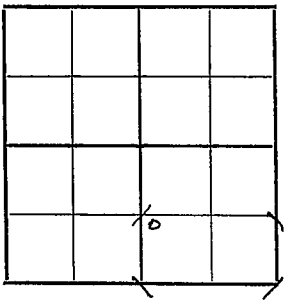

BIG CREEK POOL

Location

Rig up

Drilling and Remarks:

10" - 262'

Anhy. 756'

Drlg. 1130'

RECORD

Cased ____ in., ____ ft.

Sand

Gas

Oil

Total Depth

PRODUCTION

1st 24 hrs. Nat.

1st 24 hrs. after shot

Gas ____ Cu. Ft.

Dry Hole

Abandoned

Date

APR 1 1942 19____ S. J. LEWIS Scout

Form 26 200 Bks. 5-41 McW Russell KANSAS

Map No. 73 Sec. 6 Twp. 15 R. 14W

Well No. 1 Mitchel

Max Cohen etal. Company

ABANDONED Contractor

NW SW SE


____ Ft. from N. Line

990 Ft. from S. Line

____ Ft. from E. Line

330 Ft. from W. Line

SECTION PLAT

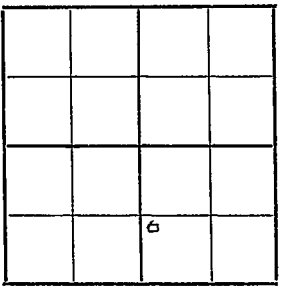

BIG CREEK POOL

Location ____

Rig up ____

Drilling and Remarks:

Cl & 3225.

Water.

RECORD

Cased ____ in., ____ ft.

Sand ____

Gas ____

Oil ____

Total Depth 3255

PRODUCTION

1st 24 hrs. Nat. ____

1st 24 hrs. after shot ____

Gas ____ Cu. Ft.

Dry Hole ____

Abandoned ____

Date

APR 29 1942 19

S. J. LEWIS Scout