


Section 12 Township 30 Range 4E

Well No. #4 Wilson "B"

Company C R A

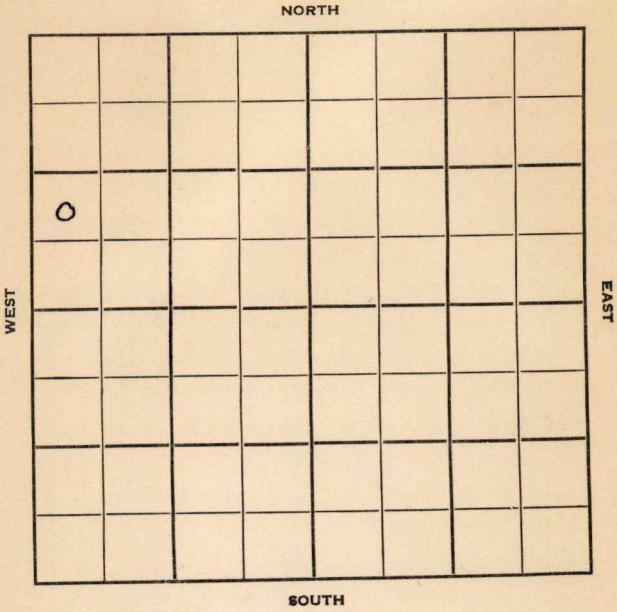

Cowley

KANSAS ✓

Sec. 12 Twp. 30 R. 1E

Well No. #4 Wilson "B" Farm

C R A Company

Rock Pool Contractor


Ft. from N. Line

990 Ft. from S. Line

Ft. from E. Line

330 Ft. from W. Line

NW SW NW (Twin)

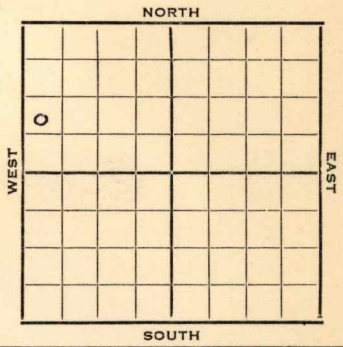

1952 Elev. 1237' REPORT

6/4 Spud 6-1-52
8" @ 62' WOC

7/2 Spud 6-1-52
D & A TD 2795' 8" @ 62
KC 2220' Bart. 2778' 5" @ 2779'
TD 2795' D & A

ABANDONED

