

Section 6 Township 16 Range 13-W

Well No. #4 H. Bitter

Company Phillips

NORTH Trapp, South Pool

WEST

EAST

SOUTH

0

KANSAS

Barton

O. W. P. B.


Sec. 6 Twp. 16 R. 13-WWell No. #4 H. Bitter FarmPhillips Company

(South Trapp)

0 Ft. from N. Line825 Ft. from S. Line825 Ft. from E. Line Ft. from W. Line

NW SE NE

Elev. 1907

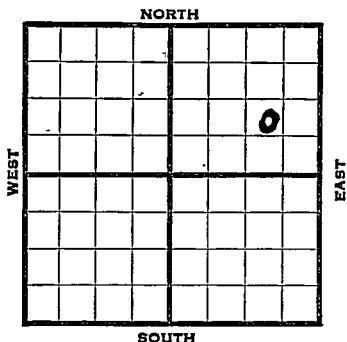

1938	REPORT
12/28	Location
1939	
1/6	B.R.R.
1/13	S. H.
1/20	Drlg. 537'.
1/27	Anhy 882'. 10" - 892'. WOC.
2/3	Drlg. 1855'.
2/10	8" - 2180'. T. D. 2360'.
	U. R. 8".
2/17	8" - 2576' Drlg. 2715
2/23	Topeka 2790' Lans. 3091'
	4 bbls. oil per hr. 3093-97'
	7" - 3105' T.D. WOC.
3/3	7" - 3198' (Was not cemented)
	Drlg. 3227'
3/10	Arb. 3344-45' T.D.
	U. R. 7" - 3297'
3/17	7" - 3344' T.D. 3356'
	Swab 342 oil in 7 hours.
3/24	T.D. 3356' 1000 acid.
	Pump 1022 oil in 35 hrs.
	2% water.

OVER

1939

3/29

7" - 3344'

Arb. 3344'

T. D. 3356

1000 acid.

Potential 2813 bbls.

Plus 6% water.

Taken by Echometer.

COMPLETED

O. W. P. R.

1955

4/13

Oil Well

TD 3356'

KC 3091', Abr. 3344'

OTD 3356'

7" @ 3344'

PB 3337'

16/3332-36

S/123 gw 3 hrs.

PB 3140'

28/3105-12

B/13 gw 3 hrs.

20/3092-97, 500A

S/58 bo 58 bw 22 hrs., 1500A

S/40 bo 211 bw 13 hrs.

S/16.38 bo 28.38 bw 4 hrs.

SP 3100'

S/1 bo 10bw

S/21½ bo 123 bw 18 hrs.

S/5.08 bo 22.12 bw 3 hrs.

CO 3138'

P/11 bo 135 bw 16 hrs.

P/62 bo 276 bw 24 hrs.

P/21 bo 131 bw 20 hrs.

P/38 bo 187 bw 24 hrs.

P/23 bo 119 bw 16 hrs.

Comp. 38 bopd 187 bw

FIRST REPORT

COMPLETED

Barton

Map No. 78 Sec. 6 Twp. 16 R. 13WWell No. 4 H. BitterPhillips

Company

Contractor

FIRST REPORT

Approx.

NW SE NE

Ft. from N. Line

825

Ft. from S. Line

825

Ft. from E. Line

Ft. from W. Line

SECTION PLAT

			②

TRAPP, SOUTH POOL

Location X

Rig up _____

Drilling and Remarks:

RECORD

Cased _____ in., _____ ft.

Sand _____

Gas _____

Oil _____

Total Depth _____

PRODUCTION

1st 24 hrs. Nat. _____

1st 24 hrs. after shot _____

Gas _____ Cu. Ft.

Dry Hole _____

Abandoned _____

Date

DEC 28 1938

19

H. D. Hatfield

Scout

Barton

KANSAS

Map No. 73 Sec. 6 Twp. 16 R. 13WWell No. 4 H. BitterPhillips

Company

Contractor

COMPLETED

Approx. NW SE NE

Ft. from N. Line

825 Ft. from S. Line825 Ft. from E. Line

Ft. from W. Line

SECTION PLAT

			0

TRAPP SOUTH POOL

Location

Rig up

Drilling and Remarks:

*1000 Acid**Pot 2813**Plus 690 wtr**Taken by Echometer***RECORD**Cased 7 in. 3344 ft.Sand Arb 3344

Gas

Oil

Total Depth 3356**PRODUCTION**

1st 24 hrs. Nat.

1st 24 hrs. after shot

Gas Cu. Ft.

Dry Hole

Abandoned

Date

MAR 29 1939

19

H. D. Hatfield Scout

County **Barton** State **O. W. Kansas**

Sec. 6 (Blk. Twp.) 16 (Sur. Rge.) 13W Map No.

Operator Phillips Pet.

Well No. 4 Farm Bitter

Elev.	Location	NW	SE	NE
-------	----------	----	----	----

FIRST REPORT

COMPLETE

825 Ft. From S Line NNE

825 Ft. From E Line Quarter

1st. Report APR 13 1955

Completion

Remarks . (OWPB)

Spudding Date **C. W. P. B.**

Drlg. Data Oil well TD 3356

KC 3091 Arb. 3344 OTD 3356 7" @ 3344

PB 3337 16/ 3332-36 S/ 123 gw 3 hr.

PB 3140 28/ 3105-12 B/ 13 gw 3 hr.

20/ 3092-97 500 A S/ 58 bo 58 bw

22 hr. 1500 A S/ 40 bo 211 bw 13 hr.

S/ 16.38 bo 28.38 bw 4 hr. SP 3100

S/ 1 bo 10 bw S/ 21 $\frac{1}{2}$ bo 123 bw 18 hr.

S/ 5.08 bo 22.12 bw 3 hr. CO 3138

P/ 11 bp 135 bw 16 hr. P/ 62 bp

276 bw 24 hr. P/ 21 bo 131 bw 20 hr.

P/ 38 bo 187 hr. 24 hr. P/ 23 bo

119 bw 16 hr. Comp. 38 bopd 187 bw

FABEN GILSTRAP