


Map No. _____ Sec. 14 Twp. 30 R. 4

Well No. 3 Magnuson Farm

Cassaday Company

NORTH

(Magnuson)

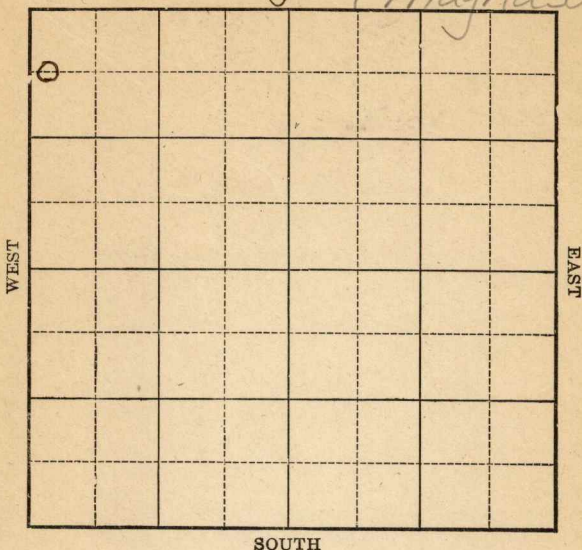

Location _____

Drilling Remarks:

Rig Up_____

Drilling Remarks:

RECORD

Cased _____ in. _____ ft.

Sand _____

Gas _____

Oil_____

Total Depth_____

PRODUCTION

1st 24 hrs. Nat. _____

1st 24 hrs. after shot_____

Gas _____ cu. ft.

Dry Hole _____

Abandoned _____

Map No. _____ Sec. 14 Twp. 30 R. 4

Well No. 3 Magnuson Farm _____
Cassady Company _____

NORTH

660 Ft. from N. Line

_____ Ft. from S. Line

_____ Ft. from E. Line

200 Ft. from W. Line

WEST

EAST

SOUTH

REPORT

Date

1923

2/6

6/23

Rig
Sand 2789-2809-
Shot 20 qts. 150 Bbls.

Map No. 14 Sec. 30 Twp. 4 R. 4Well No. 3 MagnusonCessady Company

Contractor

COMPLETED SECTION PLAT660 Ft. from N. Line

----- Ft. from S. Line

----- Ft. from E. Line

200 Ft. from W. Line

0			

Location -----

Rig up -----

Drilling and Remarks:

Sand { 2779
2809

20/150

RECORD

Cased ----- in., ----- ft.

Sand -----

Gas -----

Oil -----

Total Depth -----

PRODUCTION

1st 24 hrs. Nat. -----

1st 24 hrs. after shot -----

Gas ----- Cu. Ft.

Dry Hole -----

Abandoned -----

Date -----

JUN 23 1923

M. A. BENEAR

----- 192-----

----- Scout

Map No. KANSAS Sec. 14 Twp. 30 R. 4Well No. 3 Magnuson2 Cassady Company

Contractor

FIRST REPORT

660 Ft. from N. Line

----- Ft. from S. Line

----- Ft. from E. Line

200 Ft. from W. Line

SECTION PLAT

o			

Location -----

Rig up -----

Drilling and Remarks:

RECORD

Cased ----- in., ----- ft.

Sand -----

Gas -----

Oil -----

Total Depth -----

PRODUCTION

1st 24 hrs. Nat. -----

1st 24 hrs. after shot -----

Gas ----- Cu. Ft.

Dry Hole -----

Abandoned -----

Date FEB 6 1923

M. A. BENEAR

----- 191 -----

----- Scout