


Map No. _____ Sec. 14 Twp. 30 R. 4
Well No. 4 Magnuson Farm _____
Cassaday Company _____

NORTH

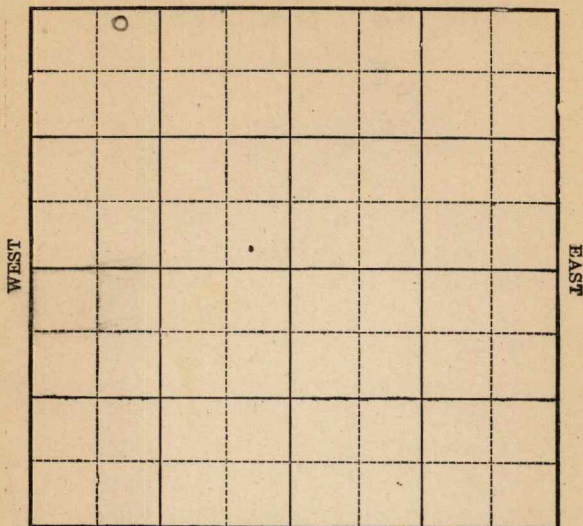

SOUTH

Location _____

Drilling Remarks:

Rig up _____

Drilling Remarks:

RECORD

Cased _____ in. _____ ft.

Sand _____

Gas _____

Oil _____

Total Depth_____

PRODUCTION

1st 24 hrs Nat. _____

1st 24 hrs. after shot_____

Gas _____ cu. ft.


Dry Hole_____

Abandoned _____

Map No. _____ Sec. 14 Twp. 230 R. 4Well No. 4 Magnuson Farm
Cassaday Company200 Ft. from N. Line

_____ Ft. from S. Line

_____ Ft. from E. Line

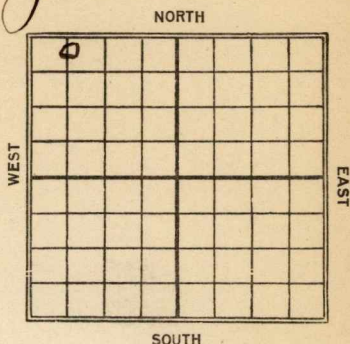660 Ft. from W. Line

REPORT

Date

1923
4/20Location8/15Top sand 2773 - Oil
2783 - 2800 - 60 Bbl. Nat.

Map No. **KANSAS** Sec. **14** Twp. **30** R. **4**

Well No. **4 Magnuson**

Cassaday Company

Contractor

FIRST REPORT

SECTION PLAT

200 Ft. from N. Line

Ft. from S. Line

Ft. from E. Line

660 Ft. from W. Line

0			

Location **RV**

Rig up

Drilling and Remarks:

RECORD

Cased _____ in., _____ ft.

Sand _____

Gas _____

Oil _____

Total Depth _____

PRODUCTION

1st 24 hrs. Nat. _____

1st 24 hrs. after shot _____

Gas _____ Cu. Ft.

Dry Hole _____

Abandoned _____

Date

APR 20 1923

Scout

11 KANSAS
 Map No. _____ Sec. 14 Twp. 30 R. 4
Well No. 4 Magnusson

Company _____

Contractor _____

COMPLETED SECTION PLAT

200 Ft. from N. Line

_____ Ft. from S. Line

_____ Ft. from E. Line

660 Ft. from W. Line

0			

Location _____

Rig up _____

Drilling and Remarks:

Tap 1.2773
oil 2783-2800'
60 bbls
Mat.

RECORD

Cased _____ in., _____ ft.

Sand _____

Gas _____

Oil _____

Total Depth _____

PRODUCTION

1st 24 hrs. Nat. _____

1st 24 hrs. after shot _____

Gas _____ Cu. Ft.

Dry Hole _____

Abandoned _____

Date _____

M. A. BENEAR

AUG 15 1923

Scout _____