

KANSAS Russell

FORM 51 25M 3-49 PETROL

Section 6 Township 15 Range 14-W

Well No. #2 Mitchell

Company C R A
Big Creek Pool

NORTH

WEST

EAST

		0					

SOUTH

KANSAS

Russell

Sec. 6 Twp. 15 R. 14-W

Well No. #2 Mitchell Farm

G R A Company


Big Creek Pool

660 Ft. from N. Line

Ft. from S. Line

990 Ft. from E. Line

Ft. from W. Line

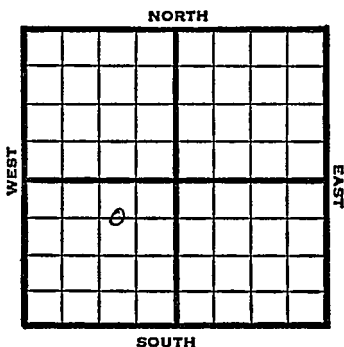

G W L NE SW

1949	Elv. 1736'	REPORT
10/26	RUR	
11/1	8" @ 770'	
	Drlg 2300'	
11/9	Lansing 2937'	
	Drlg 3093'	
11/16	Arbuckle 3189-95'	
	TD 3195'	
	5" @ 3189'	
11/23	Plug 3001	
	32 shots 2962-3020	
	1000 acid	
	Swb 25 bbls W / 5 Oil PH 48 hrs.	
11/29	"	
12/7	"	
12/14	Lans. 2937'	
	Arb. 3189'	
	5" @ 3189'	
	Perf. Lans.	
	TD 3195'	

ABANDONED

Map No. _____ Sec. 6 Twp. 15 R. 14WWell No. 2 MitchellC R A

Company

C R A

Contractor

C W L NE SW**FIRST REPORT
SECTION PLAT**660

Ft. from N. Line

Ft. from S. Line

990

Ft. from E. Line

Ft. from W. Line

	0		

Russell County

Location _____

Rig up _____

Drilling and Remarks:

R U R**RECORD**

Cased _____ in., _____ ft.

Sand _____

Gas _____

Oil _____

Total Depth _____

PRODUCTION

1st 24 hrs. Nat. _____

1st 24 hrs. after shot _____

Gas _____ Cu. Ft.

Dry Hole _____

Abandoned _____

Date

OGT 26 1949 19S. J. LEWIS

Scout

Kansas

Map No. _____ Sec. 6 Twp. 15 R. 14WWell No. 2 Mitchell

C R A

Company

ABANDONED

Contractor

C W L NE SW

51,1786
SECTION PLAT660 Ft. from N. Line Ft. from S. Line990 Ft. from E. Line Ft. from W. Line

	0		

Russell County

Location _____

Rig up _____

Drilling and Remarks:

Lane 2937
Q₂ 43189
5" @ 3189
Perf Lane.

RECORD

Cased _____ in., _____ ft.

Sand _____

Gas _____

Oil _____

Total Depth 3178

PRODUCTION

1st 24 hrs. Nat. _____

1st 24 hrs. after shot _____

Gas _____ Cu. Ft.

Dry Hole _____

Abandoned _____

Date

DEC 14 1949

19

S. J. LEWIS

Scout