


Barton

Section 6 Township 16 Range 13-W

Well No. 4 - Hoffman

Company Texas

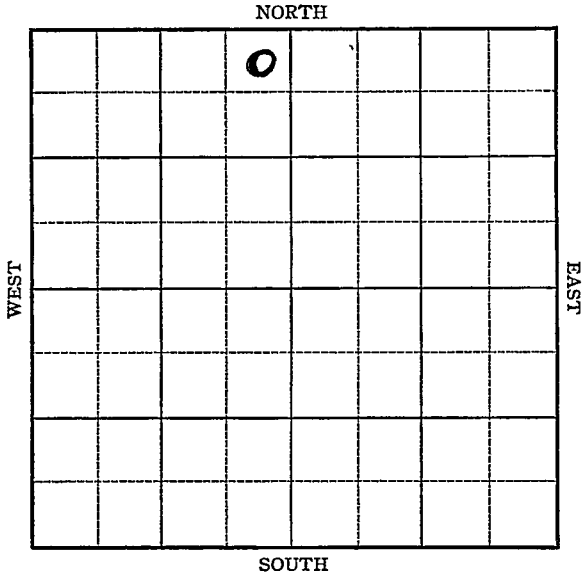

Sec. 6 Twp. 16 R. 13-W

Well No. #4 Hoffman Farm

Texas Company


330 Ft. from N. Line

 Ft. from S. Line

330 Ft. from E. Line

 Ft. from W. Line

Elev. 1912

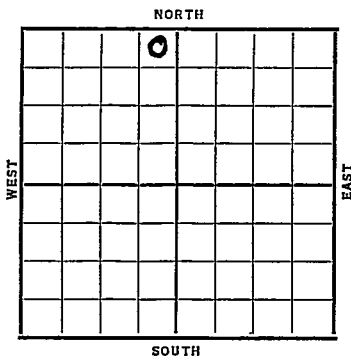

Date	REPORT
1937	
7/28	Location
8/6	"
8/13	B. R. R.
8/20	10" @ 347'. WOC.
8/28	Drl g. 2430'.
9/3	Sil. 3350'. 7" @ 3352'.
	RUST. No shows reported.
9/10	T.D. 3375'. 1st oil 3359'.
	On potential.
9/15	7" @ 3352'
	Sil 3350'
	TD 3375'
	Pot 2085
	Nat.
	COMPLETED

Barton KANSAS

Map No. 73 Sec. 6 Twp. 16 R. 13^w

Well No. 4-Hoffman
Texas Company

Contractor

FIRST REPORT

SECTION PLAT

330 Ft. from N. Line
_____ Ft. from S. Line
330 Ft. from E. Line
_____ Ft. from W. Line

	○		

Location ✓

Rig up _____

Drilling and Remarks:

RECORD

Cased _____ in., _____ ft.

Sand _____

Gas _____

Oil _____

Total Depth _____

PRODUCTION

1st 24 hrs. Nat. _____

1st 24 hrs. after shot _____

Gas _____ Cu. Ft.

Dry Hole _____

Abandoned _____

Date

JUL 28 1901 19

H. D. Hatfield Scout

Barton KANSAS

Map No. _____ Sec. 6 Twp. 16 R. 13^WWell No. 4-HoffmanTexas Company

Contractor _____

COMPLETED

330 Ft. from N. Line

_____ Ft. from S. Line

330 Ft. from E. Line

_____ Ft. from W. Line

SECTION PLAT

	0		

Location _____

Rig up _____

Drilling and Remarks:

Pat - 2085Nat.

RECORD

Cased 7 in., 3352 ft.Sand 511 3350

Gas _____

Oil _____

Total Depth 3375

PRODUCTION

1st 24 hrs. Nat. _____

1st 24 hrs. after shot _____

Gas _____ Cu. Ft.

Dry Hole _____

Abandoned _____

Date

SEP 15 1937 19

H. D. Hatfield Scout