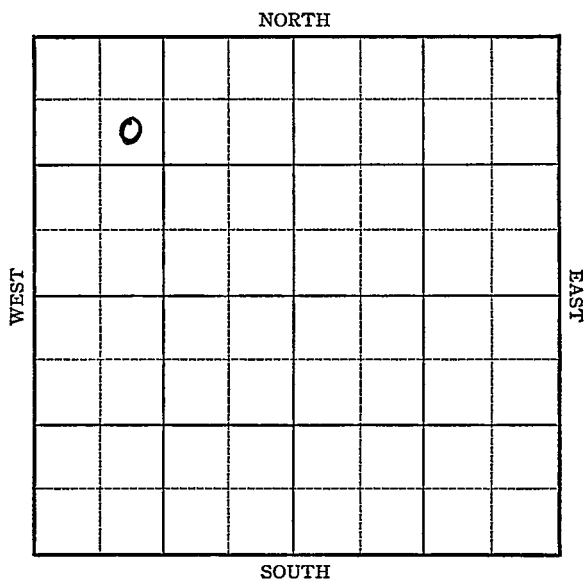


Barton


Section 6 Township 16 Range 13-WWell No. 5 HoffmanCompany Texas

KANSAS

Barton

Sec. 6 Twp. 16 R. 13-WWell No. #5 Hoffman Farm
Texas Company990 Ft. from N. Line Ft. from S. Line Ft. from E. Line990 Ft. from W. Line

Elev. 1889

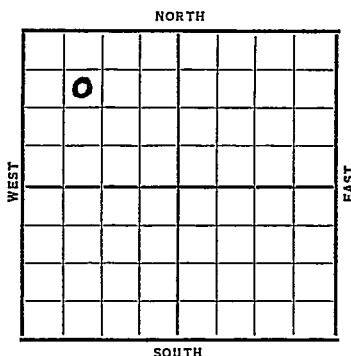

Date

REPORT

1937

10/6 Cellar.

10/15 B.R.R.

10/22 10" @ 350'. Drlg. 425'.

10/29 Drlg. 2515'.

11/5 Drlg. 3310'.

11/12 Sil. & 7" @ 3323'. Drlg. 3335'.

2800' oil.

11/17 7" @ 3323'.

Sil. 3323'.

T.D. 3340'.

1000 acid.

Potential 2441 bbls.

COMPLETED

Map No. _____ Sec. 6 Twp. 16 R. 13WWell No. 5 HoffmanTexas

Company _____

FIRST REPORT

Contractor _____

SE NW NW

990 Ft. from N. Line

_____ Ft. from S. Line

_____ Ft. from E. Line

990 Ft. from W. Line**SECTION PLAT**

0			

Location _____

Rig up _____

Drilling and Remarks:
Cellar**RECORD**

Cased _____ in., _____ ft.

Sand _____

Gas _____

Oil _____

Total Depth _____

PRODUCTION

1st 24 hrs. Nat. _____

1st 24 hrs. after shot _____

Gas _____ Cu. Ft.

Dry Hole _____

Abandoned _____

Date

Oct - 6 1937H. D. Hatfield

Scout

Barton **KANSAS**Map No. _____ Sec. 6 Twp. 16 R. 13WWell No. 5 Hoffman_____
Texas Company_____
Contractor**COMPLETED**

SE NW NW

990 Ft. from N. Line

____ Ft. from S. Line

____ Ft. from E. Line

990 Ft. from W. Line**SECTION PLAT**

0			

Location _____

Rig up _____

Drilling and Remarks:

*1000 acid**LOT-2441***RECORD**Cased 7 in., 3323 ft.Sand 511 3323

Gas _____

Oil _____

Total Depth 3340**PRODUCTION**

1st 24 hrs. Nat. _____

1st 24 hrs. after shot _____

Gas _____ Cu. Ft.

Dry Hole _____

Abandoned _____

Date

NOV 17 1937 19 H. D. Hatfield Scout