


**KANSAS**

Cowley county

Section 14 Township 30 Range 4-E

Well No. #1, Neinoller (Neimoller)

Company H. H. Blair

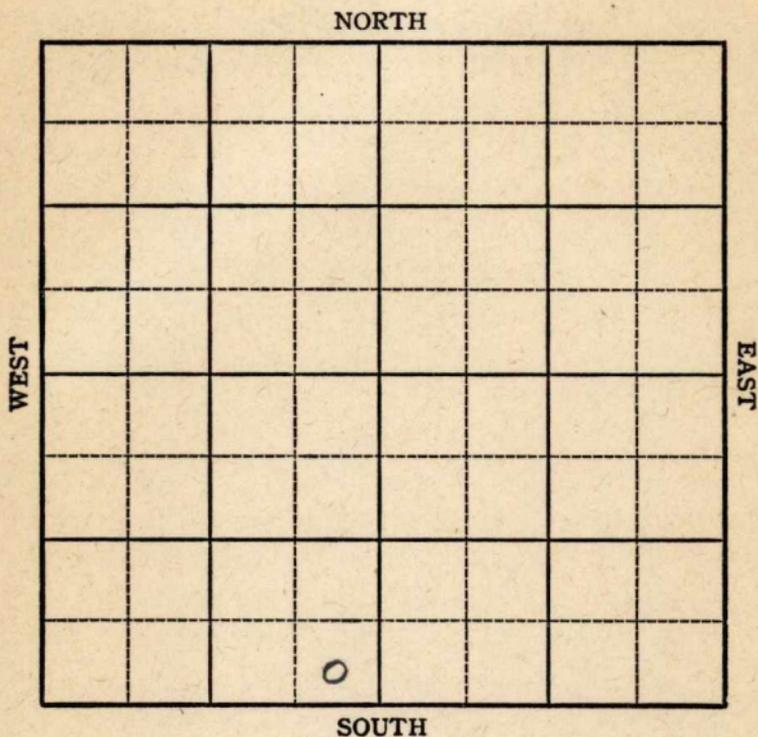

**KANSAS**

Sec. 14 Twp. 30 R. 4-E

Well No. #1, Neinoller Farm

H. H. Blair Company


Miscellaneous

\_\_\_\_\_ Ft. from N. Line

330' Ft. from S. Line

330' Ft. from E. Line

\_\_\_\_\_ Ft. from W. Line

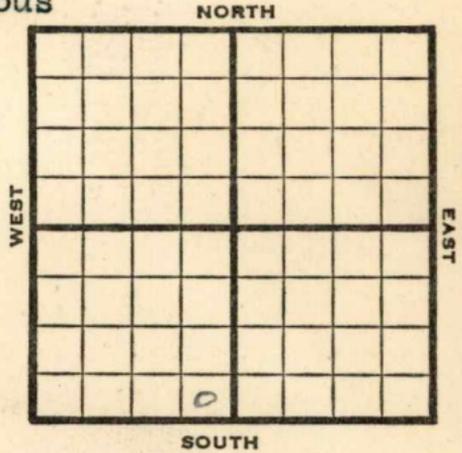

SE SW

1947 Elev. 1258 REPORT

1/22 Location

2/12 KC 2272  
Miss 2930  
TD 2937'

**ABANDONED**

**KANSAS**

Map No.     Sec. 14 Twp. 30 R. 4E

Well No. 1 Neinoller


H. H. Blair Company

FIRST REPORT Contractor

SE SW

**SECTION PLAT**

    Ft. from N. Line  
330 Ft. from S. Line  
330 Ft. from E. Line  
    Ft. from W. Line

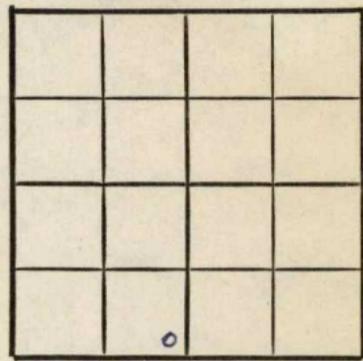

Cowley County

Location X

Rig up    

Drilling and Remarks:    

**RECORD**

Cased     in.,     ft.  
Sand      
Gas      
Oil      
Total Depth    

**PRODUCTION**

1st 24 hrs. Nat.      
1st 24 hrs. after shot      
Gas     Cu. Ft.  
Dry Hole      
Abandoned    

Date

JAN 22 1947

19

S. J. LEWIS

Scout

Map No. 11 Sec. 14 Twp. 30 R. 4E

Well No. 1 Neinoller

H. H. Blair Company

**ABANDONED**

Contractor

SE SW

**SECTION PLAT**


         Ft. from N. Line

330 Ft. from S. Line

330 Ft. from E. Line

         Ft. from W. Line

Cowley County

Location                                 

Rig up                                 

Drilling and Remarks:

*Ke 2272  
Misc 2830*

**RECORD**

Cased          in.,          ft.

Sand                                 

Gas                                 

Oil                                 

Total Depth 2830

**PRODUCTION**

1st 24 hrs. Nat.                         

1st 24 hrs. after shot                         

Gas                          Cu. Ft

Dry Hole                         

Abandoned                         

Date

FEB 12 1947

19

S. J. LEWIS Sec