

# KANSAS


Barton

Form 51-5M-7-40-Palace

Section 6 Township 16 Range 13-W

Well No. #6 Bauman

Company Cities Service Oil  
Trapp Pool

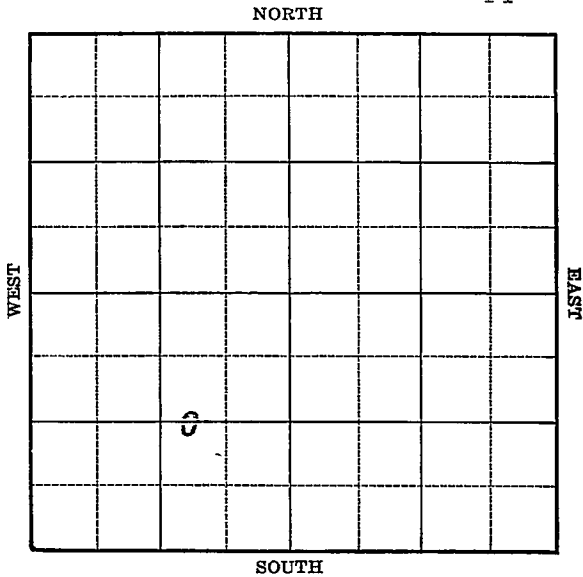

Sec. 6 Twp. 16 R. 13-W

Well No. #6 Baumart Farm

Cities-Service Oil Company


(Trapp)

\_\_\_\_\_ Ft. from N. Line

1320 Ft. from S. Line

990 Ft. from E. Line

\_\_\_\_\_ Ft. from W. Line

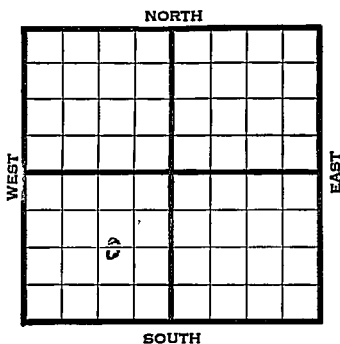

Elev. 1900

1940	REPORT
9/25	8" - 346' WOC.
10/3	Drlg. 2820'
10/10	Arb. 3334' 5" - 3335'
	T.D. 3336' RUST.
10/16	Arb. 3334'
	5" - 3335'
	T.D. 3344'
	2500 acid.
	Echometer potential 5446 bbls.
	Maximum 3000 bbls.
	COMPLETED -



Map No. 73 Sec. 6 Twp. 16 R. 13WWell No. 6 BaumanCities Service Oil Company

Contractor

**COMPLETED**C W L  $E\frac{1}{2}$  SW

\_\_\_\_\_ Ft. from N. Line

1320 Ft. from S. Line990 Ft. from E. Line

\_\_\_\_\_ Ft. from W. Line

TRAPP POOL

**SECTION PLAT**


Location \_\_\_\_\_

Rig up \_\_\_\_\_

Drilling and Remarks:

*Ce & 3334**5112 3335.**2500 acid**Echd P & 5446**May 3000***RECORD**

Cased \_\_\_\_\_ in., \_\_\_\_\_ ft.

Sand \_\_\_\_\_

Gas \_\_\_\_\_

Oil \_\_\_\_\_

Total Depth 3344**PRODUCTION**

1st 24 hrs. Nat. \_\_\_\_\_

1st 24 hrs. after shot \_\_\_\_\_

Gas \_\_\_\_\_ Cu. Ft.

Dry Hole \_\_\_\_\_

Abandoned \_\_\_\_\_

Date

OCT 16 1940 19

S. J. LEWIS Scout