


Cowley

KANSAS

Section 14 Township 30 Range 4-E

Well No. 1 Neimoller

Company Tom Palmer

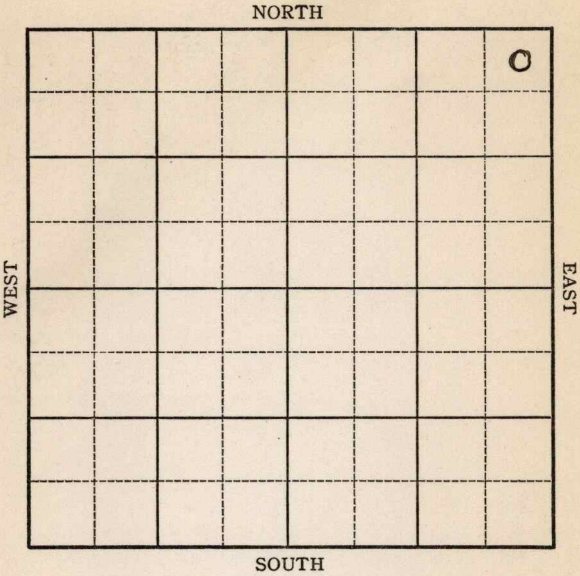

Cowley

KANSAS

Map No. // Sec. 14 Twp. 30 R. 4EWell No. 1 NeimollerTom Palmer

Company

Contractor

FIRST REPORT

NE/C

330 Ft. from N. Line Ft. from S. Line330 Ft. from E. Line Ft. from W. Line

SECTION PLAT

			0

Location Rig up

Drilling and Remarks:

Matl.

RECORD

Cased in., ft.Sand Gas Oil Total Depth

PRODUCTION

1st 24 hrs. Nat. 1st 24 hrs. after shot Gas Cu. Ft.Dry Hole Abandoned

Date

JAN 12 1938 19H. D. Hatfield

Scout

Cowley

KANSAS

Map No. 11 Sec. 14 Twp. 30 R. 4EWell No. 1 NeimollerTom Palmer

Company

Contractor

ABANDONED

NE/C

330

Ft. from N. Line

Ft. from S. Line

330

Ft. from E. Line

Ft. from W. Line

SECTION PLAT

			0

Location _____

Rig up _____

Drilling and Remarks:

*Bart. 2780-2815**MISS 2874**TD 2962**3 Bw 2945-50**D & A*

RECORD

Cased _____ in., _____ ft.

Sand _____

Gas _____

Oil _____

Total Depth 2962

PRODUCTION

1st 24 hrs. Nat. _____

1st 24 hrs. after shot _____

Gas _____ Cu. Ft.

Dry Hole _____

Abandoned _____

Date

MAR 9 - 1938

19

H. D. Hatfield Scout