

WILDCAT


FORM 513 SUNRAY

County	Russell	Elev.	
Sec.	6	Twp.	15
		Rgs.	1/4W
Company	J. W. Hummel		
Farm Name	Mudd	No.	1

TOPS	DEPTH	LOG	DATUM	Loc. in Sec.
Anh.				NW SW NE
TP.				
H.	2872			
Tr.				
Dg.				
BL.				
L. K.G.	2930			Geol. Green
K.C.				Cont.
B.K.C.				Stearns Drlg
Ce.				
C.				
M.				Pool
M.				Wildcat
K.				
Mz.				
Mo.				
V.				
S.				
S.				
A	3174			
R.				
Pf.				
G.				
TD.	RTD	3176		

FIRST REPORT	
0	
APR 3 1957	

Date Comm. 3-20-57
 8" @ 765/200. so in Arb. 5" @ 3176

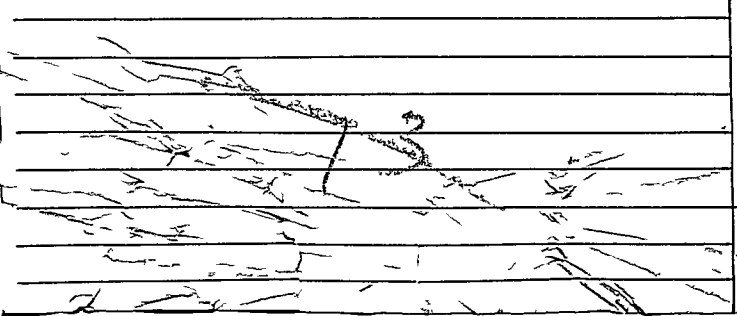


Russell KANSAS

SECTION 6 TOWNSHIP 15 RANGE 11W

WELL NO. #1 Mudd

COMPANY J.W. Hummel

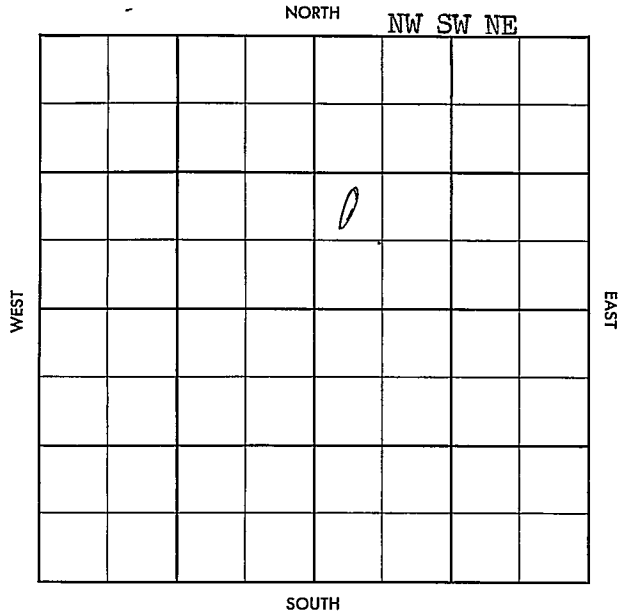

FORM 513 SUNRAY

County Russell Elev. 1738 Co.
 Sec. 6 Twp. 15 Rge. 14W
 Company J. W. Hummel
 FarmName Mudd No. 1

TOPS	DEPTH	LOG	DATUM	Loc. in Sec
Arb.				NW SW NE
TP.				
H.	2872			
Tr.				
Dg.				
Bl.				
L. <u>K.C.</u>	2930			Geol. <u>Green</u>
K.C.				Contr.
B.K.C.				Stearns Dril
Ce.				Pool <u>Carbonate</u>
C.				<u>Wildcat</u>
M.				
M.				
K.				
Mz.				
Mo.				
V.				
S.				
S.				
A.	3174			
R.				
PC.				
G.				
TD.	RTD	3176		COMPLETE

Date Comm. 3-20-57
 8" @ 765/200, so in Arb. 5" @ 3176 APR 13 '57
 Co 3176 @ 4 Bopd nolw
 2 hrs Pot APR 11 '57 APR 24 '57
 P. 25 Bopd nolw
 grav. 35°