

KANSAS

Barton

Form 51-5M-7-39-Palace

Section 6 Township 16 Range 13-W

Well No. #6 Bitter


Company Phillips

Trapp Pool

NORTH

WEST

EAST

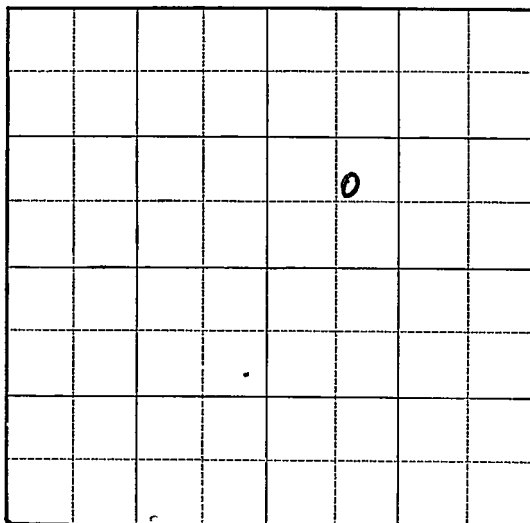

SOUTH

KANSAS

Barton

Sec. 6 Twp. 16 R. 13-WWell No. #6 Bitter FarmPhillips

Company

(Trapp)

Ft. from N. Line

825


Ft. from S. Line

Ft. from E. Line

825

Ft. from W. Line

Elev. 1911

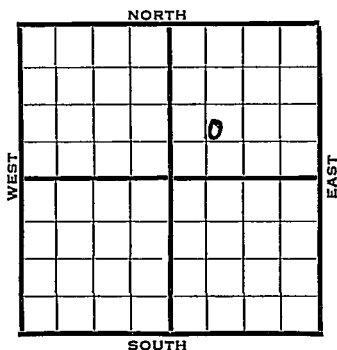

1940

REPORT

5/1	8" - 603' WOC.
5/9	2855'
5/16	Arb. 3343-44' T.D. 5" - 3343'
	RUST.
5/23	"
5/29	T.D. 3353' Swab 83 bbls. oil in
	6 hours.
6/6	1000 acid. Pump 10 bbls. per
	hour 9 hours.
6/12	Arb. 3343'
	5" - 3343'
	T.D. 3353'
	2500 acid.
	Depthograph potential 3082 bbls.
	Maximum 3000 bbls.

COMPLETED

Map No. 73 Sec. 6 Twp. 16 R. 13WWell No. 6 BitterPhillips Company

Contractor

FIRST REPORT

SW NE SW NE

 Ft. from N. Line825 Ft. from S. Line Ft. from E. Line825 Ft. from W. Line

SECTION PLAT

		o	

TRAPP POOL

Location Rig up

Drilling and Remarks:

8" - 603WOC

RECORD

Cased in., ft.Sand Gas Oil Total Depth

PRODUCTION

1st 24 hrs. Nat. 1st 24 hrs. after shot Gas Cu. Ft.Dry Hole Abandoned

Date

MAY 1 1940₁₉S. J. LEWIS

Scout

Map No. 73 Sec. 6 Twp. 16 R. 13WWell No. 6 BitterPhillips

Company

Contractor

COMPLETED**SECTION PLAT**

SW NE SW NE

Ft. from N. Line

825

Ft. from S. Line

Ft. from E. Line

825

Ft. from W. Line

		0	
		1	

TRAPP POOL

Location _____

Rig up _____

Drilling and Remarks:

*Cor & 3343**5" @ 3343**2500 acid**Depthograph R & 3082**May 3000***RECORD**

Cased _____ in., _____ ft.

Sand _____

Gas _____

Oil _____

Total Depth 3353**PRODUCTION**

1st 24 hrs. Nat. _____

1st 24 hrs. after shot _____

Gas _____ Cu. Ft.

Dry Hole _____

Abandoned _____

Date

JUN 12 1944 19S. J. LEWIS Scout