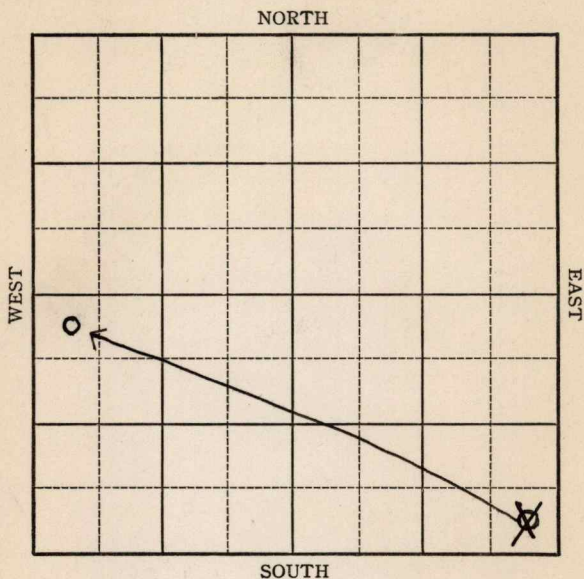


Cowley

Section 15 Township 30 Range 4-EWell No. 1 Winfield (*City of Winfield*)Company Arthur Brewer

Cowley

KANSAS

Map No. 11 Sec. 15 Twp. 30 R. 4EWell No. 1 WinfieldArthur Brewer Company

Contractor

FIRST REPORT
SE/C Ft. from N. Line330 Ft. from S. Line330 Ft. from E. Line Ft. from W. Line

SECTION PLAT

			0

Location XRig up

Drilling and Remarks:

RECORD

Cased in., ft.Sand Gas Oil Total Depth

PRODUCTION

1st 24 hrs. Nat. 1st 24 hrs. after shot Gas Cu. Ft.Dry Hole Abandoned

Date

JAN 5 - 1938 19

H. D. Hatfield Scout

Cowley **KANSAS**Map No. 11 Sec. 15 Twp. 30 R. 4EWell No. 1—WinfieldArthur Brewer Company

Contractor

CORRECTION


330 Ft. from N. Line

_____ Ft. from S. Line

_____ Ft. from E. Line

330 Ft. from W. Line

SECTION PLAT

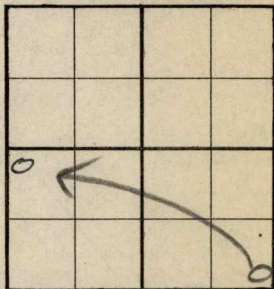

Location _____

Rig up _____

Drilling and Remarks:

*first reported
as sec
change to
N W S W*

RECORD

Cased _____ in., _____ ft.

Sand _____

Gas _____

Oil _____

Total Depth _____

PRODUCTION

1st 24 hrs. Nat. _____

1st 24 hrs. after shot _____

Gas _____ Cu. Ft.

Dry Hole _____

Abandoned _____

Date

JAN 19 1938

19

H. D. Hatfield

Scout

Cowley **KANSAS**Map No. 11 Sec. 15 Twp. 30 R. 4EWell No. 1 WinfieldArthur Brewer Company

Contractor

COMPLETED

NW SW

330 Ft. from N. Line Ft. from S. Line Ft. from E. Line330 Ft. from W. Line**SECTION PLAT**

0			

Location Rig up

Drilling and Remarks:

shot 50 gts
pot 860

RECORDCased 7 in., 2752 ft.Sand Bart 2752-2800Gas Oil Total Depth 2801**PRODUCTION**1st 24 hrs. Nat. 1st 24 hrs. after shot Gas Cu. Ft.Dry Hole Abandoned

Date

MAR 2 - 1938 19

H. D. Hatfield Scout