

KANSAS

Barton


Form 51—5M—7-40—Palace

Section 6 Township 16 Range 13-W

Well No. #8 Bitter

Company Phillips

NORTH Trapp Pool

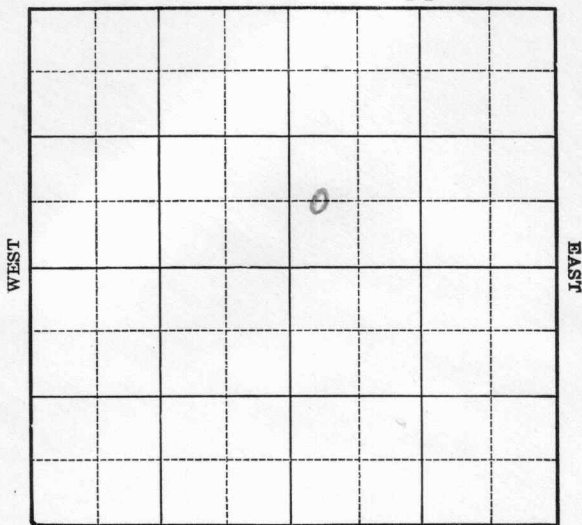

SOUTH

Sec. 6 Twp. 16 R. 13-WWell No. #8 Bitter FarmPhillips Company

(Trapp)


Ft. from N. Line

660 Ft. from S. Line

Ft. from E. Line

330 Ft. from W. Line

Elev. 1909

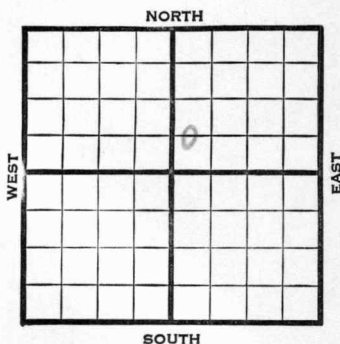

1940	REPORT
9/25	Location
10/3	8" - 612' WOC.
10/10	Drlg. 2900'
10/17	Arb. 3339' 5" - 3339' T.D 3340
	RUST.
10/24	"
10/31	T.D. 3350' Swab 13 bbls. per hour 6 hours.
11/6	Arb. 3339'
	5" - 3339'
	T.D. 3350'
	2500 acid.
	Depthograph potential 1688 bbls.
	COMPLETED

Map No. 73 Sec. 6 Twp. 16 R. 13WWell No. 8 BitterPhillips

Company

Contractor

FIRST REPORT

C W L SW NE

 Ft. from N. Line660 Ft. from S. Line Ft. from E. Line330 Ft. from W. Line

TRAPP POOL

SECTION PLAT

		o	

Location XRig up

Drilling and Remarks:

RECORD

Cased in., ft.Sand Gas Oil Total Depth

PRODUCTION

1st 24 hrs. Nat. 1st 24 hrs. after shot Gas Cu. Ft.Dry Hole Abandoned

Date

SEP 25 1940

19

S. J. LEWIS Scout

Map No. 73 Sec. 6 Twp. 16 R. 13WWell No. 8 BitterPhillips Company

Contractor

COMPLETED

C W L SW NE

 Ft. from N. Line660 Ft. from S. Line Ft. from E. Line330 Ft. from W. Line

TRAPP POOL

SECTION PLAT

		o	

Location Rig up

Drilling and Remarks:

*Cr & 3339**5" @ 3339**2500 acid**Depth. 1688*

RECORD

Cased in., ft.Sand Gas Oil Total Depth 3350

PRODUCTION

1st 24 hrs. Nat. 1st 24 hrs. after shot Gas Cu. Ft.Dry Hole Abandoned

Date

NOV 6 1940 19

S. J. LEWIS Scout