


Map No. Kansas Sec. 15 Twp. 30 R. 4
 Well No. 2 Newton Farm
Shaver & Sutter Company

NORTH

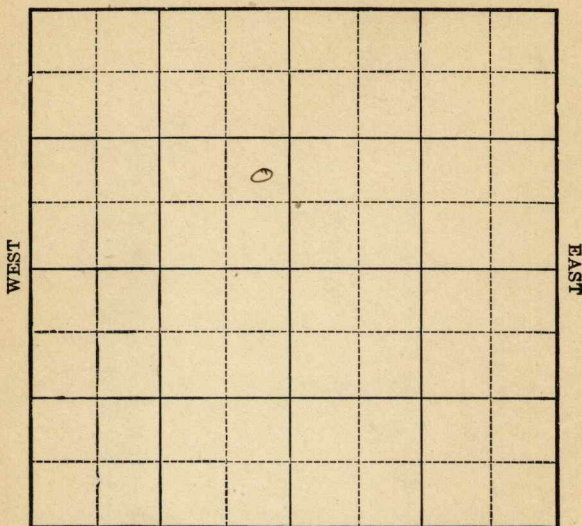

SOUTH

Location _____

Drilling Remarks _____

Rig Up _____

Drilling Remarks _____

RECORD

Cased _____ in. _____ ft.

Sand _____

Gas _____

Oil _____

Total Depth _____

PRODUCTION

1st 24 hrs. Nat. _____

1st 24 hrs. after shot _____

Gas _____ cu. ft.

Dry Hole _____

Abandoned _____


Cowley

Map No. 17NS Sec. 15 Twp. 30 R. 4Well No. 2 Newton FarmShaver & Sutter Company

Ft. from N. Line

990 Ft. from S. Line330 Ft. from E. Line

Ft. from W. Line

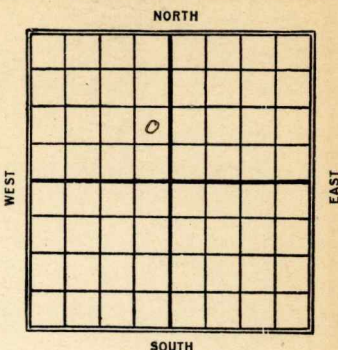

1926

Date

REPORT

7/21	Drly	1350
7/28	"	1600
8/4	"	1650
8/11	"	2175
8/18	"	2175
8/25	"	2400
8/31		
9/15	Land	2775 - 2792
		30/30 bbl.

K 11 KANSAS

Map No. _____ Sec. 15 Twp. 36 R. 4

Well No. 2 Newton

Shawyer & Sutton Company

Contractor

FIRST REPORTS

_____ Ft. from N. Line

990 _____ Ft. from S. Line

330 _____ Ft. from E. Line

_____ Ft. from W. Line

SECTION PLAT

	0		

Location _____

Rig up _____

Drilling and Remarks:

Only 1350

RECORD

Cased _____ in., _____ ft.

Sand _____

Gas _____

Oil _____

Total Depth _____

PRODUCTION

1st 24 hrs. Nat. _____

1st 24 hrs. after shot _____

Gas _____ Cu. Ft.

Dry Hole _____

Abandoned _____

Date

JUL 21 1926

CHAS. L. SHERWOOD

192

Scout

11 **KANSAS** Cowley
 Map No. _____ Sec. 15 Twp. 30 R. 4
 Well No. 2 Newton
 Shaver & Sutter Company

Contractor

COMPLETED**SECTION PLAT**

_____ Ft. from N. Line

990 _____ Ft. from S. Line

330 _____ Ft. from E. Line

_____ Ft. from W. Line

Location _____

Rig up _____

Drilling and Remarks:

20
 30 Bls.

RECORD

Cased _____ in. _____ ft.

Sand 2775-2792

Gas _____

Oil _____

Total Depth 2792

PRODUCTION

1st 24 hrs. Nat. _____

1st 24 hrs. after shot _____

Gas _____ Cu. Ft.

Dry Hole _____

Abandoned _____

Date

SEP 15 1926

CHAS. L. SHERWOOD

192

Scout