


Map No. _____ Sec. 15 Twp. 30 R. 4Well No. 2 Newton Farm _____
Hepster Gral Company _____

NORTH

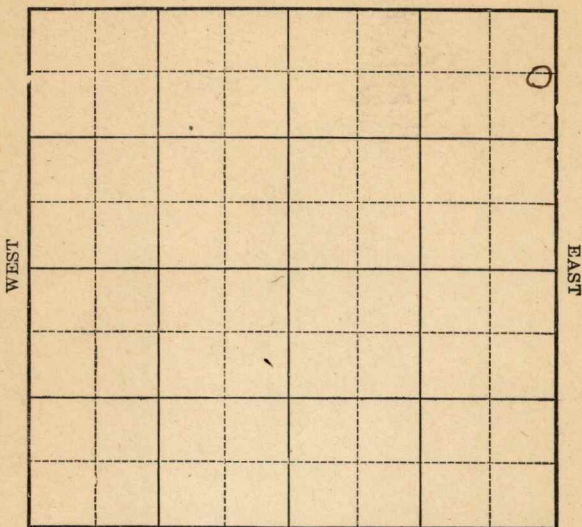

Location _____

Drilling Remarks:

Rig Up _____

Drilling Remarks:

RECORD

Cased _____ in. _____ ft.

Sand _____

Gas _____

Oil _____

Total Depth _____

PRODUCTION

1st 24 hrs. Nat. _____

1st 24 hrs. after shot _____

Gas _____ cu. ft.

Dry Hole _____

Abandoned _____

Map No. _____ Sec. 15 Twp. 30 R. 4

Well No. 2 Newton Farm
Kypler Eval Company


NORTH

660 Ft. from N. Line

Ft. from S. Line

200 Ft. from E. Line

Ft. from W. Line

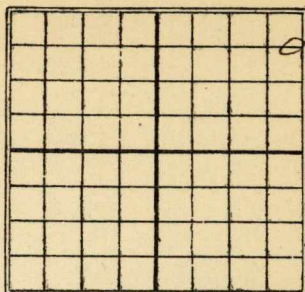

SOUTH

Date _____

REPORT

Date 1923

2/6

R.O.M.

5/19

Sand 2797-2820 - shot
40 gts. 200 Bbs.

Map No. **KAN3AS** Sec. **11** Twp. **30** R. **4**

Well No. **2 Newton**

Hepler et al Company

Contractor

COMPLETED SECTION PLAT

660 Ft. from N. Line

Ft. from S. Line

200 Ft. from E. Line

Ft. from W. Line

			0

Location

Rig up

Drilling and Remarks:

sand 2797-2820
40/200 bbb

RECORD

Cased _____ in., _____ ft.

Sand _____

Gas _____

Oil _____

Total Depth _____

PRODUCTION

1st 24 hrs. Nat. _____

1st 24 hrs. after shot _____

Gas _____ Cu. Ft.

Dry Hole _____

Abandoned _____

Date

MAY 19 1923

M. A. BENEAR

191 _____ Scout

Map No. **KANSAS** Sec. **15** Twp. **30** R. **4**Well No. **2** *Newton**Hepners et al* Company

Contractor

FIRST REPORT

SECTION PLAT

			0

660 Ft. from N. Line

Ft. from S. Line

200 Ft. from E. Line

Ft. from W. Line

RECORD

Location

Rig up

Drilling and Remarks:

R.O.G.

Cased in, ft.

Sand

Gas

Oil

Total Depth

PRODUCTION

1st 24 hrs. Nat.

1st 24 hrs. after shot

Gas Cu. Ft.

Dry Hole

Abandoned

Date

FEB 6 1923

M. A. BENEAR

191 Scout