

# KANSAS


Form 51-5M-7-40-Palace

Cowley

Section 15 Township 30 Range 4-E

Well No. #4 City of Winfield

Company Arthur Brewer  
Winfield Pool

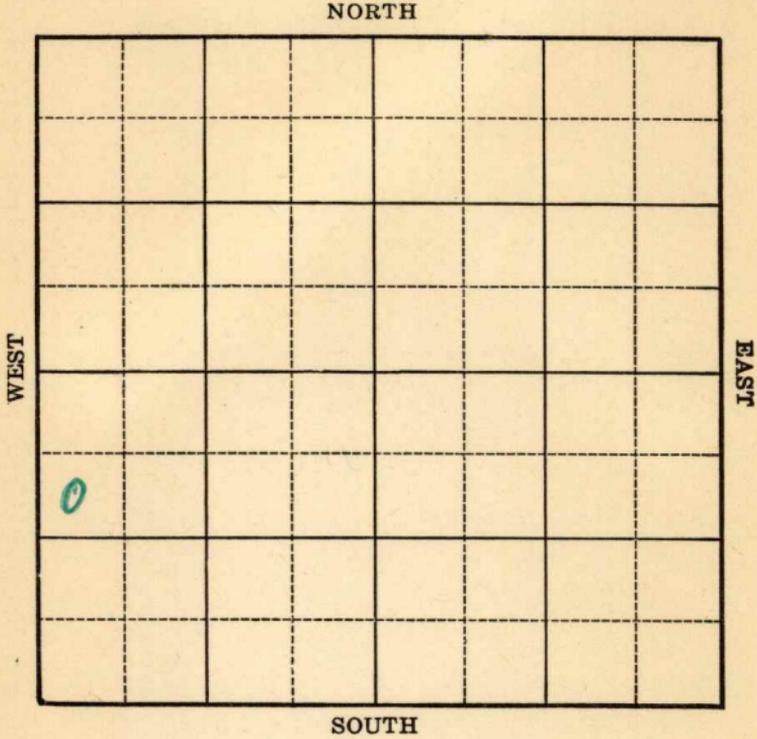

Sec. 15 Twp. 30 R. 4-E

Well No. #4 City of Winfield Farm

Arthur Brewer Company


(Winfield)

990 Ft. from N. Line

\_\_\_\_\_ Ft. from S. Line

330 Ft. from E. Line

\_\_\_\_\_ Ft. from W. Line

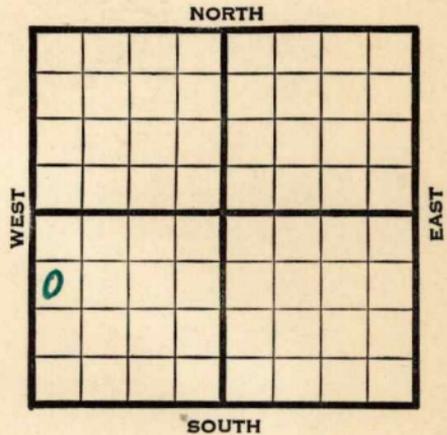

**Elev. 1171**

	REPORT
1940	
11/26	Cable .
12/5	Drlg. 450'
12/12	12" - 823' 10" - 1587'
	Drlg. 1650'
12/19	8" - 2105' Drlg. 2425'
12/26	SD 2425'
1941	
1/2	6" - 2460' Drlg. 2665'
1/9	<b>Bart. 2747'</b> 5" - 2747'
	T.D. 2787' 60 qts. 2761-85' CO.
1/15	<b>Bart. 2747'</b>
	5" - 2747'
	T.D. 2782'
	Shot 60 qts. 2761-85'
	Potential 85 bbls., pump.
	37.2 Gravity
	<b>COMPLETED</b>

Map No. // Sec. 15 Twp. 30 R. 4E

Well No. 4 City of Winfield

Arthur Brewer Company

Contractor

FIRST REPORT

SECTION PLAT

SW NW SW

990 Ft. from N. Line

Ft. from S. Line

330 Ft. from E. Line

Ft. from W. Line


WINFIELD POOL

Location

Rig up

Drilling and Remarks:  
Cable

RECORD

Cased in., ft.

Sand

Gas

Oil

Total Depth

PRODUCTION

1st 24 hrs. Nat.

1st 24 hrs. after shot

Gas Cu. Ft.

Dry Hole

Abandoned

Date

NOV 26 1940 19

S. J. LEWIS

Scout

Map No. 11 Sec. 15 Twp. 30 R. 4E

Well No. 4 City of Winfield

Arthur Brewer Company

Contractor

COMPLETED

SW NW SW

990 Ft. from N. Line

\_\_\_\_\_ Ft. from S. Line

330 Ft. from E. Line

\_\_\_\_\_ Ft. from W. Line

SECTION PLAT


WINFIELD POOL

Location \_\_\_\_\_

Rig up \_\_\_\_\_

Drilling and Remarks:

*Bar 2747*  
*5" @ 2747*  
*60 gals 2761-85*  
*Pump 85 PD*  
*37 2/3 Gr*

RECORD

Cased \_\_\_\_\_ in., \_\_\_\_\_ ft.

Sand \_\_\_\_\_

Gas \_\_\_\_\_

Oil \_\_\_\_\_

Total Depth 2787

PRODUCTION

1st 24 hrs. Nat. \_\_\_\_\_

1st 24 hrs. after shot \_\_\_\_\_

Gas \_\_\_\_\_ Cu. Ft.

Dry Hole \_\_\_\_\_

Abandoned \_\_\_\_\_

Date

JAN 15 1941 19

S. J. LEWIS Scout