


DX 78-1 Cowley

KANSAS

Section 15 Township 30 Range 4E

Well No. 1 Lorton

Company Stelbar Oil

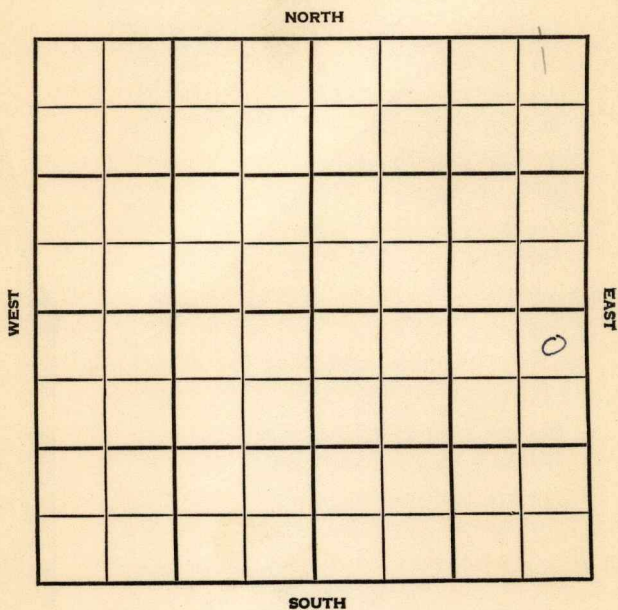

Cowley

KANSAS

SEC.	TWP.	R.
15	30	4E

WELL NO.

#1 Lorton

FARM

COMPANY

Stelbar Oil

CONTRACTOR

Co. Tools.

Rock Pool

330


Ft. from N. Line

Ft. from S. Line

330

Ft. from E. Line

Ft. from W. Line

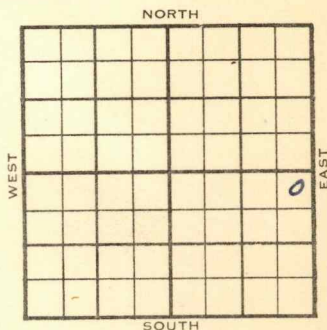

NE NE SE

1955

ELEVATION

1212'

REPORT

4/27

M I R

6/22

Comm 4-23-55

KC 2238

BKC 2480

8 5/8" @ 53/50 5 1/2" @ 2784-75

CO to 2799 frac P/16 bopd 6 bw

Comp 20 bopd 7 bw

COMPLETED

County Cowley State Kansas
Sec. 15 (Blk.) 30 (Sur.) 4E Map No.
(Twp.)
Operator Stelbar Oil
Well No. 1 Farm Lorton
Elev. Location NE NE SE

FIRST REPORT

330 Ft. From N Line SE
330 Ft. From E Line Quarter
1st. Report APR 27 1955
Completion
Remarks
Co. tools
Spudding Date

Drlg. Data

Rock PoolM I R

FABEN GILSTRAP

County Cowley Elev. 1212
 Sec. 15 Twp. 30 Rge. 4E
 Company Stelbar Oil
 Farm Name Lorton Est. No. 1

TOPS	DEPTH	LOG	DATUM	Loc. in Sec.
Anh.				NE NE SE
Tp.				
H.				
Tr.				
Dg.				
B.L.				
L.				Geol.
K.C.	2238		1026	Contr.
B.K.C.	2480		1268	
Ce.				
C.				
M.				Pool
M.				Rock
K.				
Mz.				
Mq.				
V.				
S.				
S.				
A.				
R.				
Pe.				
G.				
T.D.	3799			

COMPLETE

Date Comm. 4-23-55 JUN 22 1955

8 5/8" @ 53/50 5 1/2" @ 2784-75

CO to 2799 frac P/ 16 bopd 6 bw

Comp. 20 bopd 7 bw