


Map No. K Sec. 15 Twp. 30 R. 4

Well No. 1 Magnusson Farm
Shaver & Suttler Company

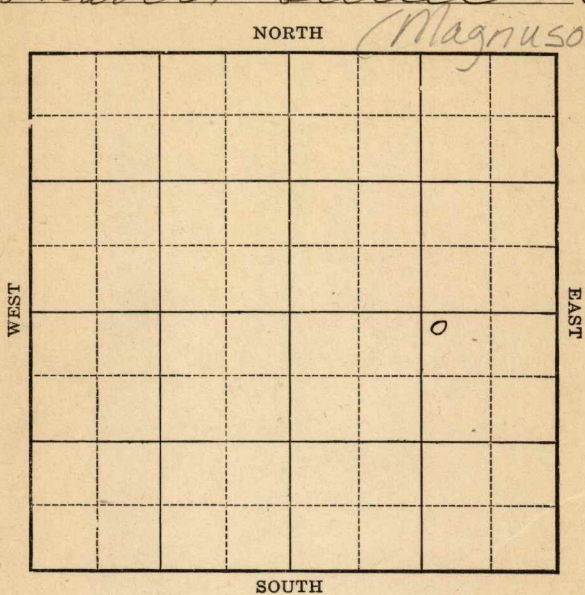

Location _____

Drilling Remarks:

RECORD

Cased _____ in. _____ ft.

Sand _____

Gas _____

Oil _____

Total Depth _____

Rig Up _____

Drilling Remarks:

PRODUCTION


1st 24 hrs. Nat. _____

1st 24 hrs. after shot _____

Gas _____ cu. ft.

Dry Hole _____

Abandoned _____

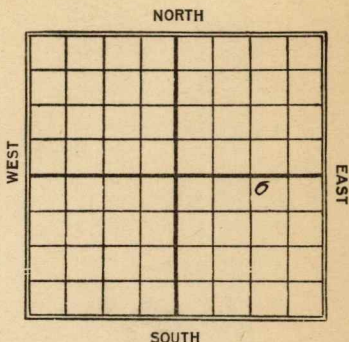Map No. K Sec. 15 Twp. 30 R. 4Well No. 1 Magnuson Farm
Shaver, Litter Company200 Ft. from N. Line Ft. from S. Line1120 Ft. from E. Line Ft. from W. Line

Date

REPORT

1922
11/30 Lly 1450'1924
1/24 Sho del 3255-61
D & d q. 3305'

Map No. **KANSAS** 11 Sec. 15 Twp. 30 R. 4Well No. 1 MagnusonShaner & Sutter Company

Contractor

FIRST REPORT

SECTION PLAT

200' Ft. from N. Line

_____ Ft. from S. Line

1620' Ft. from E. Line

_____ Ft. from W. Line

			○

Location _____

Rig up _____

Drilling and Remarks:

Log 1430

RECORD

Cased _____ in., _____ ft.

Sand _____

Gas _____

Oil _____

Total Depth _____

PRODUCTION

1st 24 hrs. Nat. _____

1st 24 hrs. after shot _____

Gas _____ Cu. Ft.

Dry Hole _____

Abandoned _____

Date

NOV 30 1923

M. A. BENEAR

192_____

Scout

Map No. KANSAS Sec. 15 Twp. 30 R. 4Well No. #1 - MagnusonShawner & Sutter Company

Contractor

ABANDONED**SECTION PLAT**200 Ft. from N. Line

_____ Ft. from S. Line

1120 Ft. from E. Line

_____ Ft. from W. Line

			o

Location _____

Rig up _____

Drilling and Remarks:

show oil 3255-61LO + A3305'**RECORD**

Cased _____ in., _____ ft.

Sand _____

Gas _____

Oil _____

Total Depth _____

PRODUCTION

1st 24 hrs. Nat. _____

1st 24 hrs. after shot _____

Gas _____ Cu. Ft.

Dry Hole _____

Abandoned _____

Date

JAN 24 1924192M. A. BENEAK

Scout

MAP No. K11 KANSAS SEC. 15 TWP. 30S 4E

WELL No. 1 Magnuson
Sutter - Stearns COMPANY

CONTRACTOR

SECTION PLAT

ABANDONED

_____ FT. FROM N. LINE
_____ FT. FROM S. LINE
_____ FT. FROM E. LINE
_____ FT. FROM W. LINE

			0

LOCATION _____

RIG UP _____

DRILLING AND REMARKS:

RECORD

CASED _____ IN. _____ FT.
SAND _____
GAS _____
OIL _____
TOTAL DEPTH 3305

PRODUCTION

1ST 24 HRS. NAT. _____
1ST 24 HRS. AFTER SHOT _____
GAS _____ CU. FT.
DRY HOLE ✓
ABANDONED ✓

DATE

1/25 192 ✓ SCOUT