


DX 78-1

Russell KANSAS

Section 6 Township 15 Range 11W

Well No. 2 Mudd

Company Kessler & Schmidt

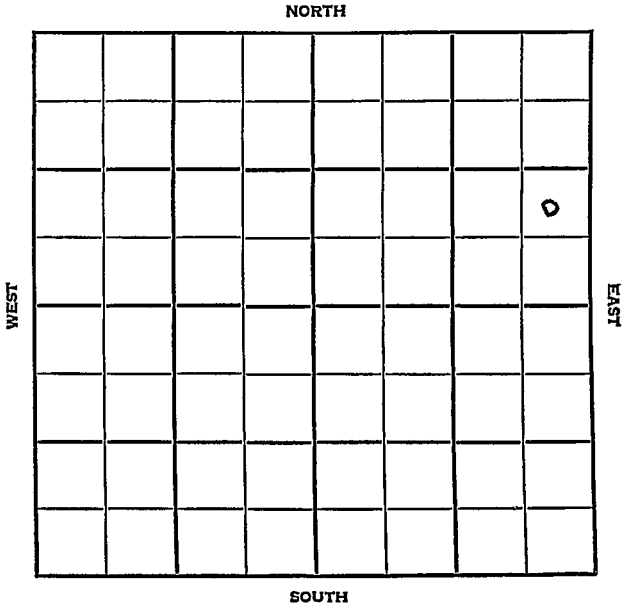


Russell KANSAS

SEC	TWP	R
6	15	14 W
WELL NO.		
# 2 Mudd		FARM
COMPANY		
Kessler & Schmidt		
CONTRACTOR		

Mast Drlg.
Hall-Gurney Pool

_____ Ft. from N. Line
990 _____ Ft. from S Line
330 _____ Ft. from E Line
_____ Ft. from W Line

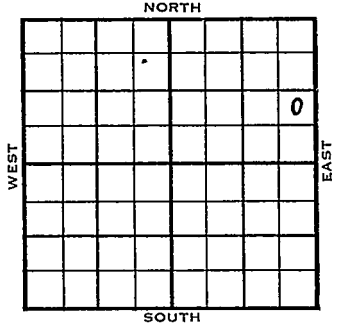

NE SE NE

ELEVATION	REPORT
1954	1772'
10/20	Spud 10-17-54 8" @ 229 WOC
12/1	Spud 10-17-54 - Temp. Abnd. TD 3236' 8" @ 229' Top. 2685' DST 2685-96', opn 1/2 hrs., rec. 5' mid, 80# DST 2975-97', opn 1 hr., rec. 60' OCM, 0# Lans. 2997', Arb. 3218' TD 3223' 5" @ 3220' DD 3226' 250 A wtr. PB 3070' 56/2992-99, 288/3004-40, 3000A 4 bo 35 bw 24 hrs. PB 2410' 91/2384-92, Tarkio 2365', 2nd Tarkio 2384' S/25 bwph frac, 10 bopd 18 bwph Temp. Abdn.

ABANDONED

OVER

