

KANSAS

Barton


Form 51-5M-7-39-Palace

Section 6 Township 16 Range 13-W

Well No. #11 Bitter "B"

Company Shell

NORTH Trapp Pool

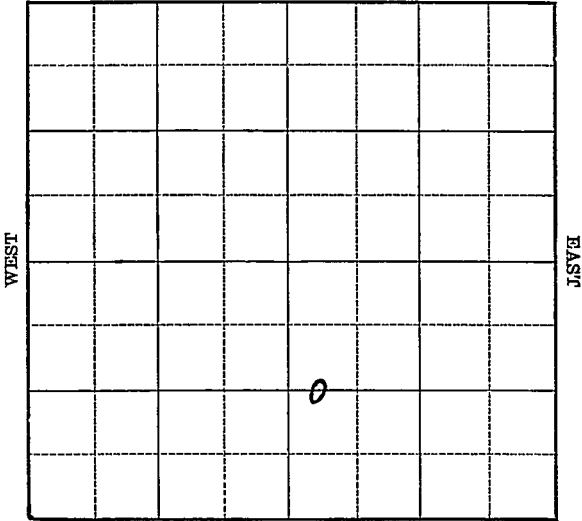

SOUTH

Sec. 6 Twp. 16 R. 13-W

Well No. #11 Bitter "B" Farm _____

Shell Company _____


(Trapp)

_____ Ft. from N. Line

1305 Ft. from S. Line

_____ Ft. from E. Line

330 Ft. from W. Line

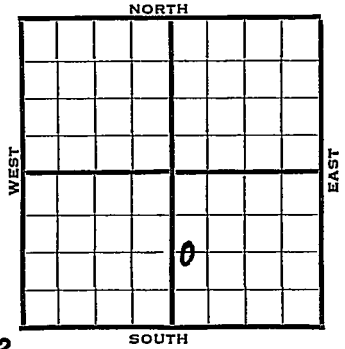

Elev. 1912

1940	REPORT
4/17	8" - 663' WOC.
4/25	Drlg. 2764'
5/2	Top. 2802' Arb. 3343-45' T.D. 4" - 3344' WOC.
5/9	S.O. 3348-50' T.D. 3352' 4000 acid. Swab 283 bbls. oil 6 hours. 500' off bottom.
5/15	Arb. 3343' 4" - 3344' T.D. 3352' 4000 acid. Depthograph potential: 2051 bbls.
	COMPLETED

Map No. 73 Sec. 6 Twp. 16 R. 13W

Well No. 11 Bitter "B"

Shell Company

Contractor

COMPLETED

G W L SE

SECTION PLAT

_____ Ft. from N. Line

1305 Ft. from S. Line

_____ Ft. from E. Line

330 Ft. from W. Line

TRAPP POOL

Location _____

Rig up _____

Drilling and Remarks:

cut 3343
4" @ 3344
4000 acid
Geothographt
2051

RECORD

Cased _____ in., _____ ft.

Sand _____

Gas _____

Oil _____

Total Depth 3352

PRODUCTION

1st 24 hrs. Nat. _____

1st 24 hrs. after shot _____

Gas _____ Cu. Ft.

Dry Hole _____

Abandoned _____

Date

MAY 15 1940 19

S. J. LEWIS Scout