


Section 6 Township 16 Range 13W

Well No. #11 Hoffman

Company Texas Co.

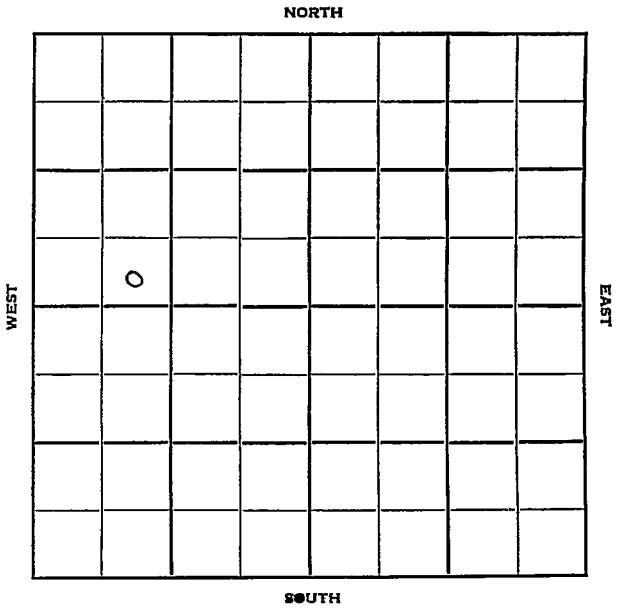

Barton

Sec. 6 Twp. 16 R. 13W

Well No. #11 Hoffman Farm

Texas Co. Company

Contractor

Trapp Pool


_____ Ft. from N. Line

330' Ft. from S. Line

_____ Ft. from E. Line

990' Ft. from W. Line

SE SW NW

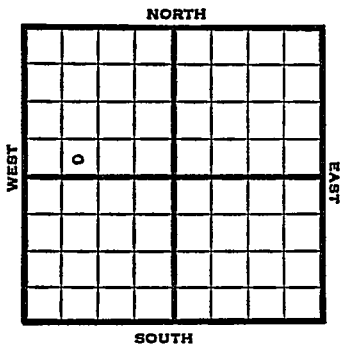

1951

Elev. 1909' REPORT

5/9

Location

6/20

Spud 5-7-51
Oil Well TD 3364
10" @ 880
Heeb. 3030 Lans. 3116
Arb. 3328
TD 3364
7" @ 3359
FU 2200' wtr
PB 3355
7/3338-44 B/5 bailers oil 1 hr
P 51 bo 79 bw 19 hr.
Comp. 38 bo 153 bwpd

COMPLETED

O.W.W.O.

FORM 513 SUNRAY

County Barton Elev. 1909
 Sec. 6 Twp. 16 Rgs. 13W
 Company Shell Oil
 FarmName Hoffman No. 11

TOPS	DEPTH	LOG	DATUM	Loc. in Sec.
Anh.				SE SW NW
TP.				
H.				O.W.O.
Tr.				
Dg.				Geol. <u>O.W.W.O.</u> Contr.
Bl.				
L.	3118			Pool Trapp
K.C.				
R.K.C.				FIRST REPORT FEB 13 57 COMPLETE
Ce.				
C.				No.
M.				
M.				Sec.
K.				
Mz.				T.
Mo.				
V.				R.
S.				
S.	3328			
A.				
R.				
PE.				
G.				
T.D.	3361			

Date Comm.

7" @ 3359 PB 32 1/2 20/ 3199-3201
 B/ 2 gw 1000 A P/ 30 to 7 bw 2 1/2 hr.
 Comp. 1 bopd 5 bw

18