


Section 2 Township 16 Range 4W

Well No. #2 Kelley

Company Franco Central et al

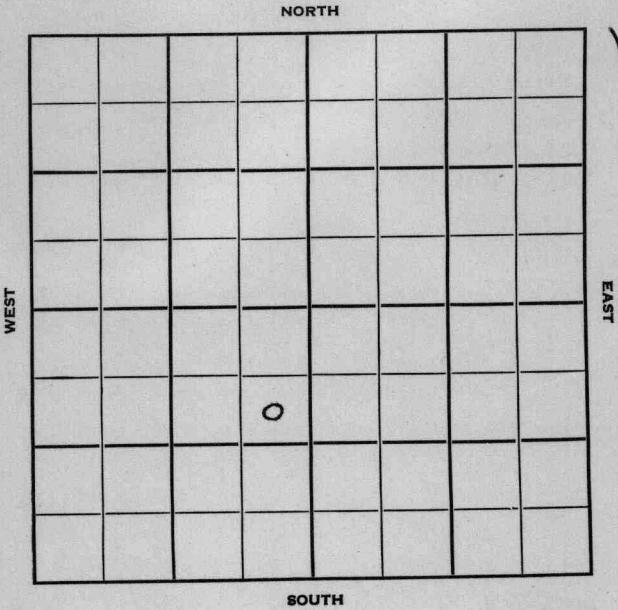

Saline

KANSAS

Sec. 2 Twp. 16 R. 1W

Well No. #2 Kelley O.W.W.O. Farm

McPHERSON OIL & DEV. CO.

~~Franco Central et al~~ Company

Shields Contractor
Smolan Pool


990 Ft. from N. Line

Ft. from S. Line

330 Ft. from E. Line

Ft. from W. Line

SW $\frac{1}{4}$ SE NE SW

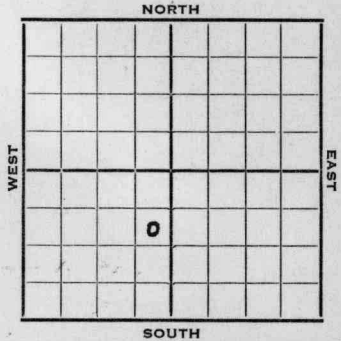

1952 Elev. 1345 REPORT

- 10/29 MIM
- 11/5 NR
- 11/12 8" @ 375'
Drlg. 2520'
- 11/20 Miss 2956' KH 3238' Mq Sha 3452'
Mq Dol 3454'
- 11/27 V 3512, Simp sha 3598, Simp
Dol 3600
RTD 3602, 5" @ 3601, DD 3646
TD PB
- 12/4 PB 3510 47/3457-61 1500' wtr in hole
sq off
- 12/11 24/3454-56 500A SO SQ OFF
- 12/18 14/3454-56 500A 15 BWPB
- 12/25 " " "
- 1/1 S/20 5 BU / 4 BO 14 Hrs. CO 3500
- 1/8 Shut Down
- 1/22 "
- 1/29 "
- 2/5 "
- 2/12 "

OVER

1953

2/18 Spudding Date 11/3/52
D&A TD 3646
8" @ 375 Miss. 2956 KH. 3238
Maq sh. 3452 Maq dol. 3454 Viola
Viola 3512, Simp. sh. 3598 Simp
dol 3600 TD 3602 5" @ 360; DD 3646
wtr. PB 3510 47/3457-61 FU 1500'
wtr. 24/3454-56 500 A 14/3454-56
500 A 15 bwph S/205 bw 4 bo 14 hr,
CO to 3500
D&A

ABANDONED

O.W.W.O.

1953

6/24 Maq. sh. 3452, Maq. dol 3454, Viola
3512, Simp Sh. 3598, Simp dol. 3600.
OTD 3646'
5" @ 3601'
CO to 3465
12/ 3453-55 SSW 7 bwph & 6 bopd
115 bwpd to sq. perf.

8/5 No report

9/16 Oil Well
TD 3646
Maq. sh. 3452, Maq. dol. 3454, Viola
3512, Simp. sh. 3598, Simp dol 3600
OTD 3646
5" @ 3601
CO to 3465
12/3453-55, SSW 7 bwph 6 bo
P/6 bopd 115 bw
P/6 bopd 120 bw
Comp. 4 bopd 6 bw

COMPLETED

