


Section 2 Township 16 Range 4W

Well No. #3 Kelly

Company McPherson Oil

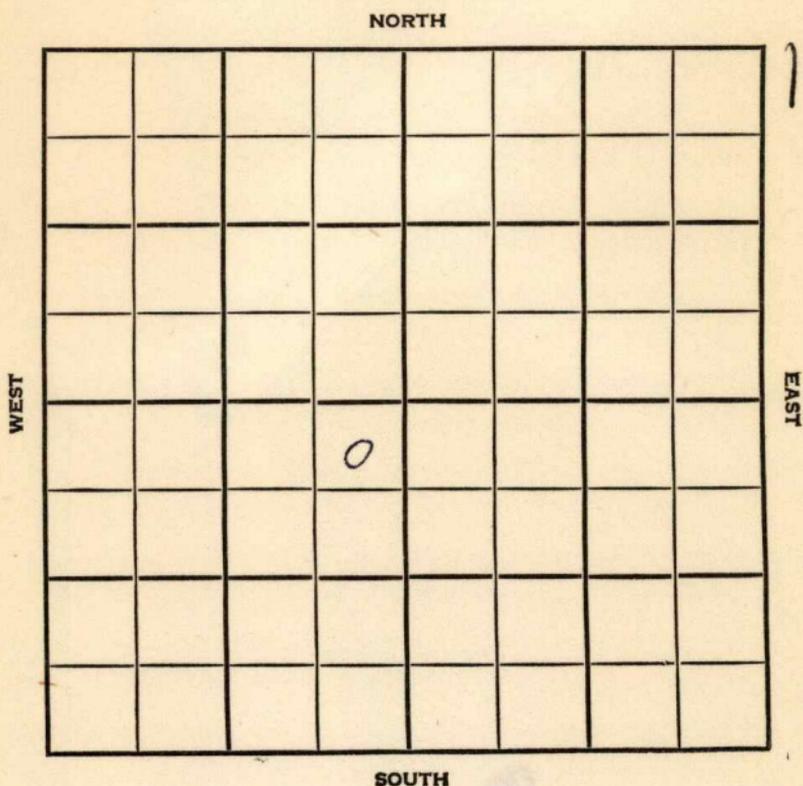

Saline

KANSAS


SEC.	TWP.	R.
2	16	4 W

WELL NO. # 3 Kelly FARM

COMPANY McPherson Oil

CONTRACTOR Melland Smolan Pool

330 Ft. from N. Line  
 \_\_\_\_\_ Ft. from S. Line  
 330 Ft. from E. Line  
 \_\_\_\_\_ Ft. from W. Line

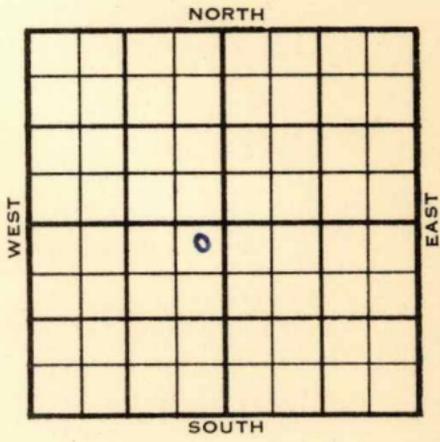

NE NE SW

1955	ELEVATION	REPORT
------	-----------	--------

3/23 Spud 3-17-55  
 8" @ 450  
 Drlg. 884'

County **Saline** State **Kansas**

Sec. **2** (Blk.) **16** (Sur. Rge.) **4W** Map No.

Operator **McPherson Oil**

Well No. **3** Farm **Kelly**

Elev. Location **NE NE SW**

FIRST REPORT							

**330** Ft. From **N** Line **SW**

**330** Ft. From **E** Line **Quarter**

1st. Report **MAR 23 1955**

Completion

Remarks

**Melland - Contr.**

Spudding Date **3-17-55**

Drlg. Data **Smolan Pool**

**8" @ 450 drlg. 884**

FABEN GILSTRAP