


Section 2 Township 16 Range 4^W
Well No. 4 Carlson
Company El Dorado Ref.

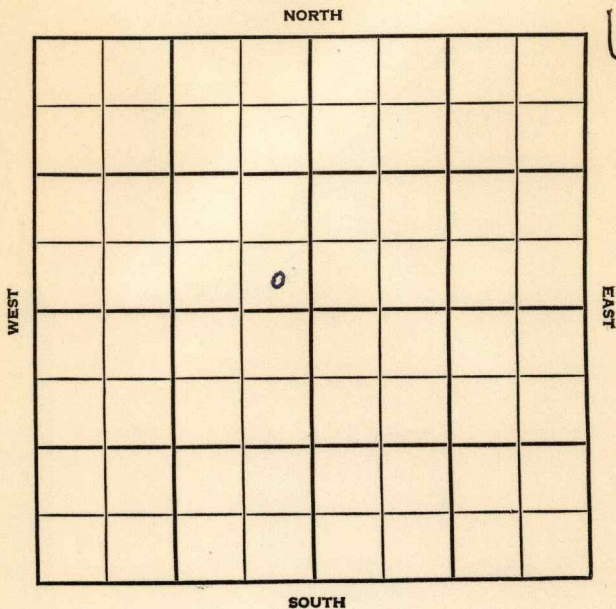

Saline KANSAS

SEC.	TWP.	R.
2	16	4W

WELL NO.

4 Carlson

FARM

COMPANY

El Dorado Ref.

CONTRACTOR

Lewis Drlg.
Smolan Pool

Ft. from N. Line

330


Ft. from S. Line

330

Ft. from E. Line

Ft. from W. Line

SE SE NW

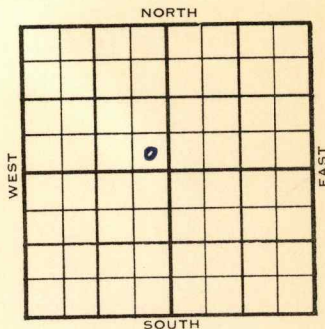

1955

ELEVATION
1336'

REPORT

1/12

MIR

2/23

Spud 1-12-55

Oil Well

TD 3445'

8" @ 401'

Kh. 3212', Hunton 3381' Maq Sh. 3394'
Maq. dol. 3441'

TD 3445'

5" @ 3441'

CO to 3445 B/ 15 go 35 gwph
3 hr. A-frac. S/ 2 bo 5 bwph 6 hr
Comp 38 bopd. 48% Wtr.

COMPLETED

FABEN GILSTRAP

County Saline State KansasSec. 2 (Blk. 16 (Sur. 4W (Twp. Map No. (Rge.)Operator ElDorado Ref.Well No. 4 Farm CarlsonElev. 1336 Location SE SE NW330 Ft. From S Line NW330 Ft. From E Line Quarter1st. Report Completion FEB 23 1955Remarks Smolan PoolLewis Drlg. - Contr.Spudding Date 1-12-55Drlg. Data Oil well TD 34458" @ 401 Kh. 3212 Hunton 3381Maq. sh. 3394 Maq. dol. 3441 TD 34455" @ 3441 CO to 3445 B/ 15 go 35 gwph3 hr. A-frac S/ 2 bo 5 bwph 6 hr.Comp. 38 bopd 48% wtr.

FABEN GILSTRAP