


DX 78-1

Section 2 Township 16 Range 4W

Well No. #4 Kelly

Company McPherson Oil

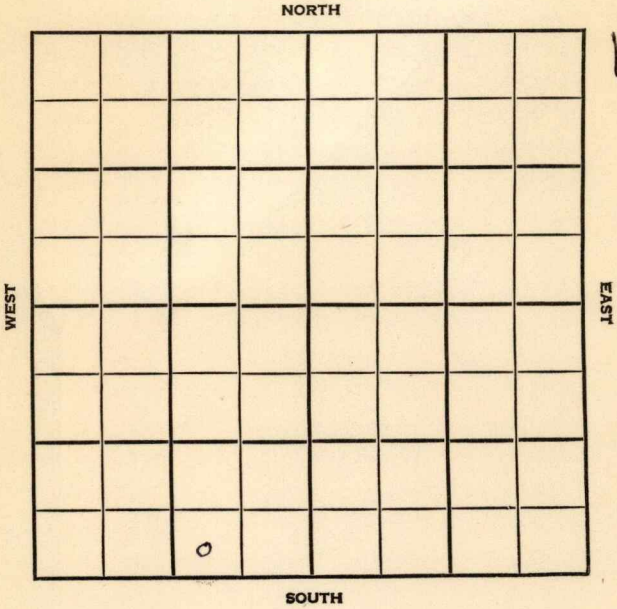

Saline KANSAS


SEC.	TWP.	R.
2	16	4W

WELL NO. 4 Kelly FARM

COMPANY McPherson Oil

CONTRACTOR Melland
Smolan Pool

 Ft. from N. Line
330 Ft. from S. Line
990 Ft. from E. Line
 Ft. from W. Line

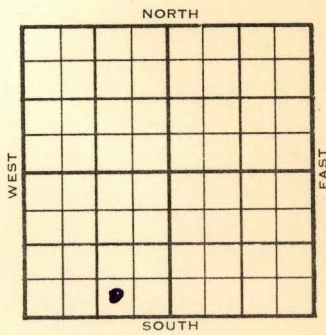

SW SE SW

1955	ELEVATION	REPORT
------	-----------	--------

4/6 Spud 3-31-55
8" @ 413'
Drlg. 1600'

County Saline State Kansas
Sec. 2 (Blk.) 16 (Sur.) 4W Map No.
Operator McPherson Oil
Well No. 4 Farm Kelly
Elev. Location SWSE SW

FIRST REPORT

0

330 Ft. From S Line SW
990 Ft. From E Line Quarter
1st. Report APR 6 1955

Completion

Remarks

Melland - Contr.

Spudding Date 3-31-55

Drlg. Data Smolan Pool

8" @ 413 drlg. 1600

FABEN GILSTRAP