


Section 2 Township 16 Range 4 W

Well No. # 4 Lockstrom

Company Derby Oil

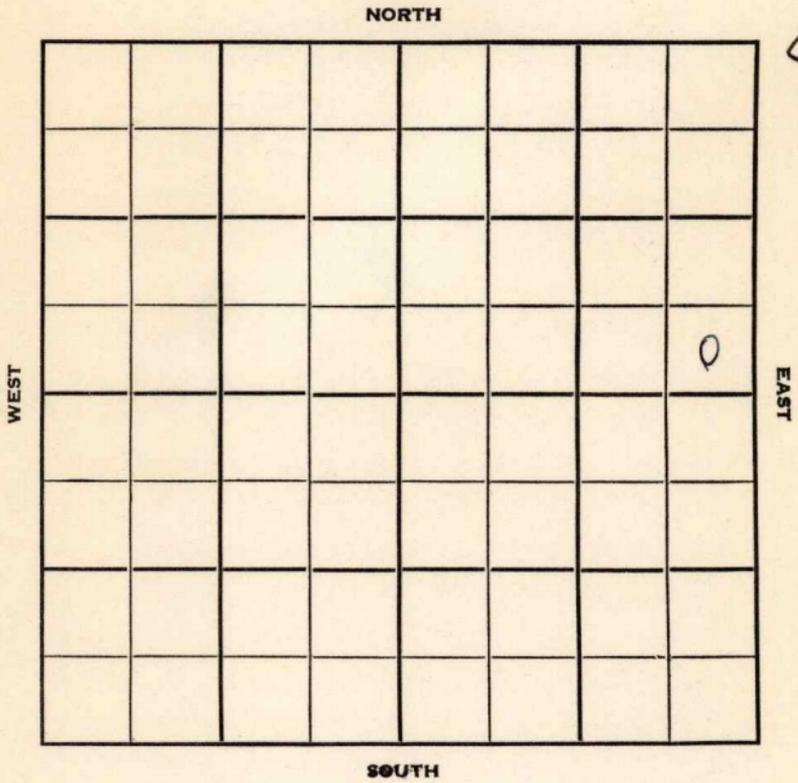

Saline

KANSAS

Sec. 2 Twp. 16 R. 4W

Well No. #4 Lockstrom Farm

Derby Oil Company

Carey Contractor

Smolan


_____ Ft. from N. Line

330 Ft. from S. Line

330 Ft. from E. Line

_____ Ft. from W. Line

SE SE NE

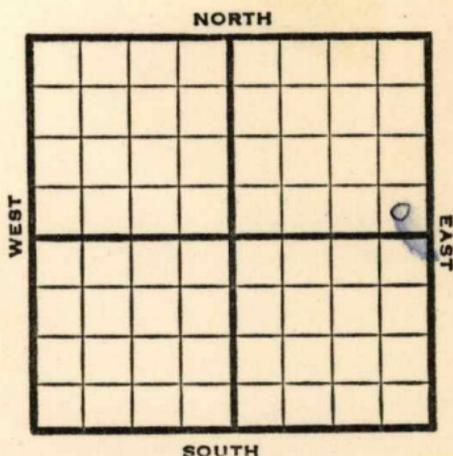

1951

Elev. 1315'

REPORT

10/31

Location

1952

1/2

Spud 11-7-51

Oil Well TD 3431

8" @ 330

Miss 2910

Kh. 3354

Maq. sh. 3362

Maq. dol. 3429

5" @ 3430

TD 3431

FU 100' oil 15 hr.

18/ 3429-31 250 A FU 550' wtr.

380' oil 15hr. S/ 11 BO 5 hr.

55% wtr. P/ 11½ BO 2½ BW 8 hr.

Comp. 104 BOPD 24 % wtr.

COMPLETED

County **Saline** State **Kansas**

Sec. **2** (Blk. (Twp.) **16**) (Sur. (Rge.) **4W**) Map No.

Operator **Derby Oil**

Well No. **4** Farm **Lockstrom**

Elev. Location **SE SE NE**

FIRST REPORT											

330 Ft. From **S** Line **NE**

330 Ft. From **E** Line Quarter

1st. Report **OCT 31 1951**

Completion

Remarks

Carey - Contr.

Spudding Date

Drlg. Data **Smolan**

Location

J. E. TYRA

