


Section 2 Township 16 Range 4W

Well No. #4 Sandberg

Company Jones, Shelburne & Farmer

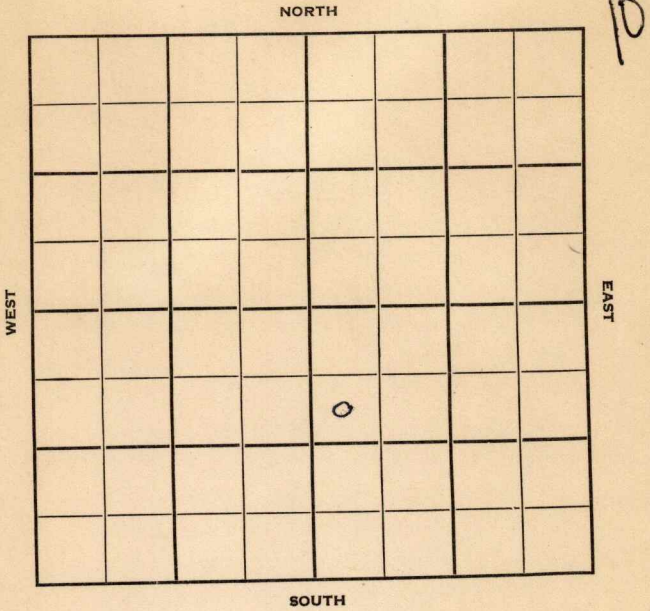

Saline

KANSAS

Sec. 2 Twp. 16 R. 4W

Well No. #4 Sandberg Farm

Jones, Shelburne & Farmer Company

J-S-F Contractor

Smolan Pool


990 Ft. from N. Line

\_\_\_\_\_ Ft. from S. Line

\_\_\_\_\_ Ft. from E. Line

330 Ft. from W. Line

SW NW SE

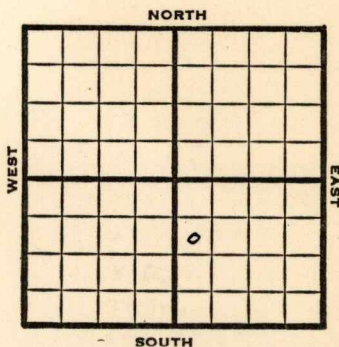

1953 **Elev. 1343** REPORT

10/1 RUR

10/8 8" @ 368, Drlg. 1044'

10/15 Topeka 1880, KC 2390  
Drlg. 3285'

10/22 Miss 2950', KH 3232', Mq sha  
3379', Mq Dol 3452  
RTD 3453'  
5" @ 3452'

10/29 NR

11/5 "

11/12 Spud 10-5-52  
Oil well TD 3453' 8" @ 368  
Anhy 350' Ft. Riley 1440' Top. 1880'  
KC 2390' Miss 2950' Kh. 3232'  
Maq. sh. 3379' Maq. dol. 3452'  
TD 3453' 5" @ 3452 CO to 3453'  
FU 600' oil 8 hr. B/2 BOPH  
P/50 BOPD 250 A  
Comp. 124 BOPD 3% wtr.

**COMPLETED**



