


DX 78-1

Section 2 Township 16 Range 1W

Well No. #6 Lockstrom

Company Derby Oil

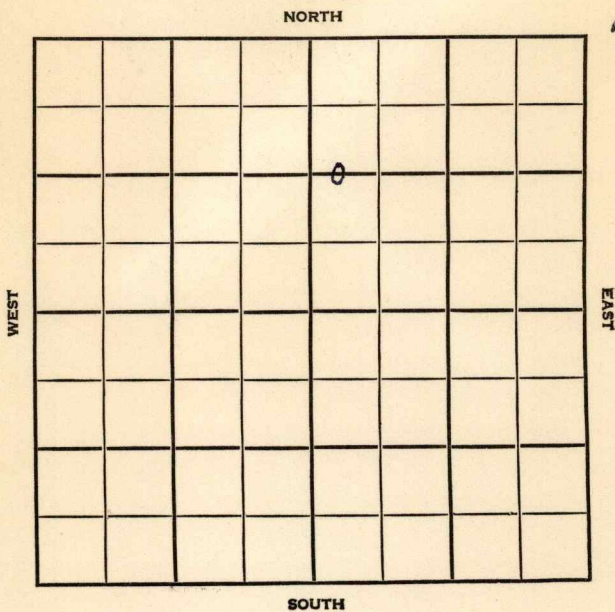

Saline KANSAS

SEC.	TWP.	R.
2	16	4 W

WELL NO. FARM

6 Lockstrom

COMPANY

Derby Oil

CONTRACTOR

Glenn Peel
Smolan Pool


1320 Ft. from N. Line

Ft. from S. Line

Ft. from E. Line

330 Ft. from W. Line

C $W\frac{1}{2}$ $W\frac{1}{2}$ NE

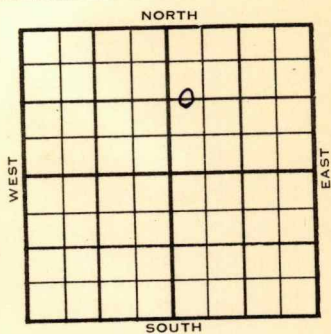

	ELEVATION	REPORT
1954	1340'	
9/8	Spud 9-7-54	
	8" @ 348 WOC	
11/3	Spud 9-7-54	
	Oil Well	
	TD 3449'	
	8" @ 348'	
	Miss 2926', Kh. 3222', Maq. 3446'	
	TD 3449'	
	5" @ 3447'	
	CO to 3449'	
	8.6 bo 6 hr. 500 A 1000 A 3 boph	
	5 hr. 2000 A 11.7 bf 35% Wtr. 3 hr	
	148 bo 32 bw 24 hr.	
	Comp 215 bopd. 10% Wtr.	

COMPLETED

County Saline State KansasSec. 2 (Blk.) 16 (Sur.) 4W Map No.Operator Derby OilWell No. 6 Farm LockstromElev. Location C W $\frac{1}{2}$ W $\frac{1}{2}$ NE

FIRST REPORT


1320 Ft. From N Line NE330 Ft. From W Line Quarter1st. Report SEP 8 1954

Completion

Remarks

Glenn Peel - Contr.Spudding Date 9-7-54Drlg. Data Smolan Pool8" @ 348 WOC

FABEN GILSTRAP

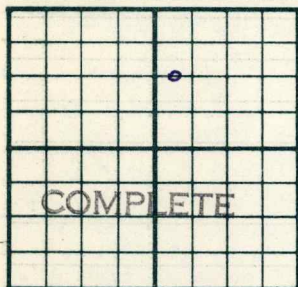County Saline State KansasSec. 2 (Blk.
Twp.) 16 (Sur.
Rge.) 4W Map No.Operator Derby OilWell No. 6 Farm LockstromElev. 1340 Location C W $\frac{1}{2}$ W $\frac{1}{2}$ NE1320 Ft. From N Line NE330 Ft. From W Line Quarter1st. ReportCompletion Nov 3 1954Remarks Smolan PoolGlenn Peel - Contr.Spudding Date 9-7-54Drlg. Data Oil well TD 34498" @ 348 Miss. 2926 Kh. 3222Maq. 3446 TD 3449 5" @ 3447 CO to 34498.6 bo 6 hr. 500 A 1000 A 3 boph5 hr. 2000 A 11.7 bf 35% wtr. 3 hr148 bo 32 bw 24 hr.Comp. 215 bopd 10% wtr.

FABEN GILSTRAP