


Section 2 Township 16 Range 4W

Well No. 8 Lockstrom

Company Derby Oil

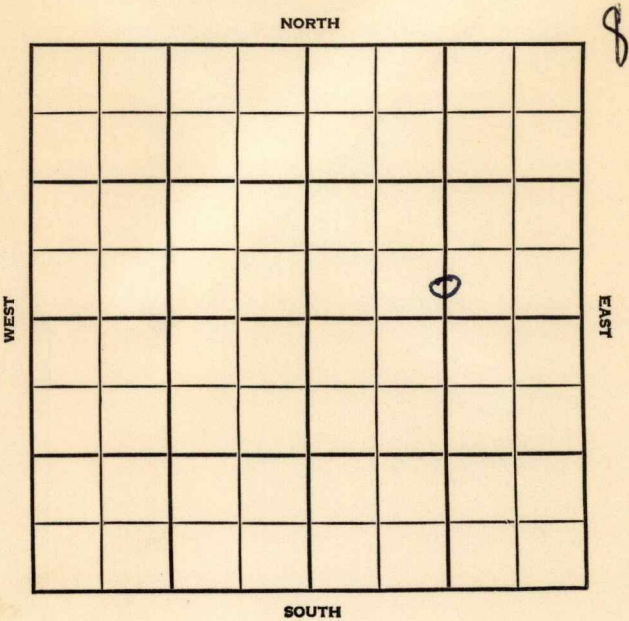

Saline

KANSAS

SEC.	TWP.	R.
2	16	4 W

WELL NO.

8 Lockstrom

FARM

COMPANY

Derby Oil

CONTRACTOR

Glenn W. Peel

Smolan Pool

Ft. from N. Line


330

Ft. from S. Line

1320

Ft. from E. Line

Ft. from W. Line

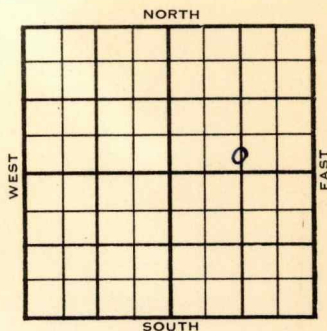C S $\frac{1}{2}$ S $\frac{1}{2}$ NE

1954

ELEVATION

1329'

REPORT

10/13

Spud 10-8-54

8" @ 430

Drlg. 1855'

11/23

Spud 10-8-54 Oil well TD 3444

8" @ 430 Miss 2920 Kh. 3208

Maq. 3439 TD 3441 5" @ 3440


CO to 3441 1/35 BOPH 8% wtr. 3 hr.

500 A S/22 BO 2 $\frac{1}{2}$ BW 10 hr frac.DD 3444 S/2 $\frac{1}{2}$ BO 1 $\frac{1}{4}$ BWPH 11 hr.

frac. S/32 BO 25 BW 5 hr.

Comp. 183 BOPD 9% wtr.

COMPLETED

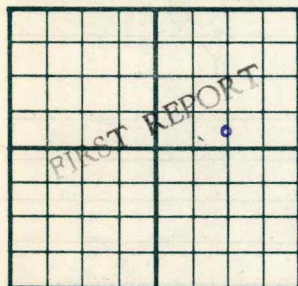County **Saline** State **Kansas**Sec. **2** (Blk. Twp.) **16** (Sur. Rge.) **4W** Map No.Operator **Derby Oil**Well No. **8** Farm **Lockstrom**Elev. Location **C S $\frac{1}{2}$ S $\frac{1}{2}$ NE****330** Ft. From **S** Line **NE****1320** Ft. From **E** Line Quarter1st. Report **OCT 13 1954**


Completion

Remarks

Glenn W. Peel - Contr.Spudding Date **10-8-54**Drlg. Data **Smolan Pool****8" @ 430 drlg. 1855**

FABEN GILSTRAP

County Saline State Kansas
 Sec. 2 (Blk.) 16 (Sur.) 4W Map No. _____
 Operator Derby Oil
 Well No. 8 Farm Lockstrom
 Elev. 1329 Location C S $\frac{1}{2}$ S $\frac{1}{2}$ NE

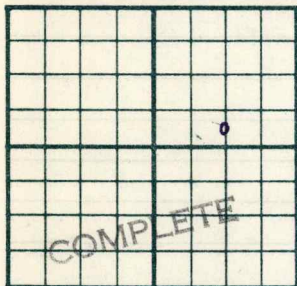

330 Ft. From Line
1320 Ft. From Line Quarter
 1st. Report _____
 Completion NOV 23 1954
 Remarks Smolan Pool
Glenn W. Peel - Contr.
 Spudding Date 10-8-54

Drlg. Data Oil well TD 3444
8" @ 430 Miss. 2920 Kh. 3208
Maq. 3439 TD 3441 5" @ 3440 CO to 3441
1/35 boph 8% wtr. 3 hr. 500 A
S/ 22 bo 2 $\frac{1}{2}$ bw 10 hr. frac DD 3444
S/ 2 $\frac{1}{2}$ bo 1 $\frac{1}{4}$ bwph 11 hr. frac
S/ 32 bo 25 bw 5 hr. Comp. 183 bopd
9% wtr.

FABEN GILSTRAP