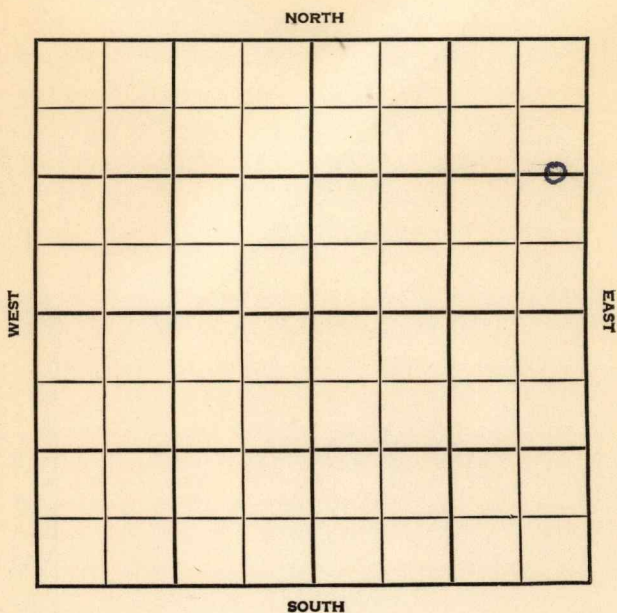


Section 2 Township 16 Range 4WWell No. 9 LockstromCompany Derby Oil

## Saline KANSAS

|      |      |    |
|------|------|----|
| SEC. | TWP. | R. |
| 2    | 16   | 4W |

WELL NO.

9 Lockstrom

FARM

COMPANY

Derby Oil

CONTRACTOR

Glen W. Peel

Smolan Pool

1320

Ft. from N. Line


Ft. from S. Line

330

Ft. from E. Line

Ft. from W. Line

C E/2 E/2 NE

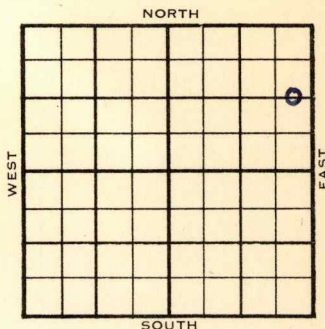

1954

ELEVATION

REPORT

1325'

10/20

Spud 10-19-54  
8" @ 437', WOC

11/23

Spud 10-19-54 Oil well TD 3439  
 8" @ 437 Miss. 2922 Kh. 3208  
 Maq. 3437 TD 3439 5" @ 3438  
 CO to 3439 S/1 BOPH 4 hr. 1000 A  
 S/15.75 BO 1.88 BW 4 hr. 2000 A  
 6 BOPH 1 BW 4 hr.  
 Comp. 198 BOPD

**COMPLETED**

County Saline State Kansas

Sec. **2** (Blk.) **16** (Sur.) **4W** Map No.

Operator **Derby Oil**

Well No. 9 Farm Lockstrom

| Elev. | Location | C | E <sub>2</sub> <sup>1</sup> | E <sub>2</sub> <sup>1</sup> | NE |
|-------|----------|---|-----------------------------|-----------------------------|----|
| 60    | 100      |   |                             |                             |    |
| 70    | 100      |   |                             |                             |    |
FIRST REPORT

1320 Ft. From N Line NE

330 Ft. From **E** Line Quarter

1st. Report OCT 20 1954

### Completion

Remarks


Glen W. Peel - Contr.

Spudding Date 10-19-54

Drlg. Data Smolan Pool

8<sup>th</sup> @ 437 WOC

FABEN GILSTRAP

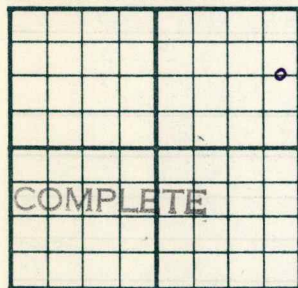County Saline State KansasSec. 2 (Blk. 16 (Sur. 4W (Twp.) Map No.Operator Derby OilWell No. 9 Farm LockstromElev. 1325 Location C E  $\frac{1}{2}$  E  $\frac{1}{2}$  NE1320 Ft. From N Line NE330 Ft. From E Line Quarter1st. ReportCompletion NOV 23 1954Remarks Smolan PoolGlenn W. Peel - Contr.Spudding Date 10-19-54Drlg. Data Oil well TD 34398" @ 437 Miss. 2922 Kh. 3208Maq. 3437 TD 3439 5" @ 3438 CO to3439 S/ 1 boph 4 hr. 1000 AS/ 15.75 bo 1.88 bw 4 hr. 2000 A6 boph 1 bw 4 hr.Comp. 198 bopd

FABEN GILSTRAP